

MISSISSIPPI DEPARTMENT OF NATURAL RESOURCES
Bureau of Land and Water Resources
 Southport Mall
 P.O. Box 10631
 Jackson, Mississippi 39209
WATER WELL DRILLERS LOG

TIPPAH
D 2018

8.8.87 19 Medlin Well Drilling Tippah
 date well completed firm name county well located

LANDOWNER:
John Wood
Walnut, MS.
 (mailing address)

description of formations encountered	from	to
Clay & Sand	0	90
Rock & Clay	90	140
Aquifer & Sand	140	190

WELL LOCATION:
 sec. 13 T. 2 N. R. 4 E
 S W
2 miles SE of Walnut
 (distance) (direction) (nearest town)

WELL PURPOSE:
 (home) Irrigation, municipal, industrial

- WELL COMPLETION DATA:**
- (1) diameter (inches) 4"
 - (2) total depth (feet) 180'
 - (3) static water level (feet) 90' below above top of ground.
 - (4) casing PVC, 190'
 (material) (depth)
 (size) if telescope see back.
 - (5) screen 10', 170'
 (length) (depth to top)
4", PVC
 (size) (material)
 - (6) pump 3/4, 12
 (HP) (yield gpm)
Electric
 (type power)
 - (7) electric log _____
 (yes or no)

 (organization running log)
 - (8) how well bottom plugged _____

RECEIVED


SEP 28 1989

Department of Natural Resources
 Bureau of Land & Water Resources

DRILLERS REMARKS:

If well telescopes please
sketch and show depths.

GROUND LEVEL

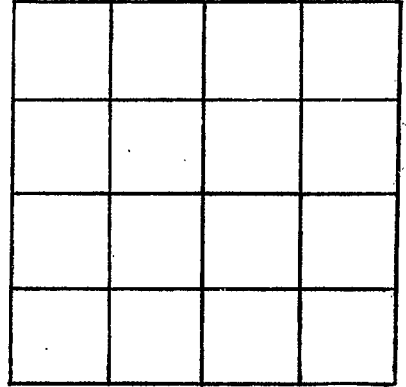

SECTION _____

Please indicate well location X.

ADDITIONAL INFORMATION

If more than one screen,
show locations of each on sketch.
