

MISSISSIPPI DEPARTMENT OF NATURAL RESOURCES

Bureau of Land and Water Resources

Southport Mall

P.O. Box 10631

Jackson, Mississippi 39209

WATER WELL DRILLERS LOG

Tippah  
D  
2023

3-20 1991 Marven Houston Well Co Tippah  
 date well completed firm name county well located


LANDOWNER: W.A. Jackson  
Rt 2 Box 172  
Walnut, Miss. 38683  
 (mailing address)

description of formations encountered	from	to
	<u>Red Clay</u>	<u>0</u>
<u>Red Sand</u>	<u>20</u>	<u>60</u>
<u>Coak</u>	<u>60</u>	<u>62</u>
<u>Red Sand</u>	<u>62</u>	<u>110</u>

WELL LOCATION:  
 sec. 13 T. 2 N. R. 4 E.  
3 miles SE of Chalybeat  
 (distance) (direction) (nearest town)

WELL PURPOSE: Home  
 (home, irrigation, municipal, industrial)

- WELL COMPLETION DATA:
- (1) diameter (inches) 4
  - (2) total depth (feet) 110
  - (3) static water level (feet) 72 below above top of ground.
  - (4) casing Plastr, 110,  
 (material) (depth)  
4 If telescope see back.  
 (size)
  - (5) screen 10 110  
 (length) (depth to top)  
4 Plastr  
 (size) (material)
  - (6) pump 3/4 10  
 (HP) (yield gpm)  
Elec  
 (type power)
  - (7) electric log no  
 (yes or no)
  - (organization running log)
  - (8) how well bottom plugged 4" log

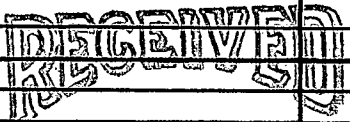


APR 12 1991

Dept. of Environmental Quality  
 Bureau of Land & Water Resources

DRILLERS REMARKS:

If well telescopes please sketch and show depths.

GROUND LEVEL

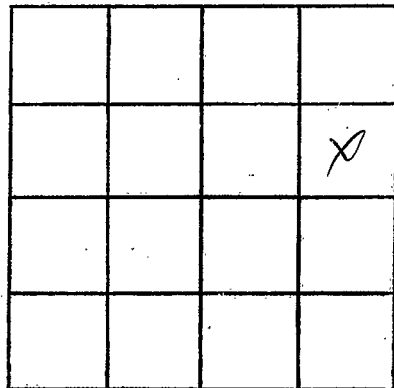

SECTION 13

Please indicate well location X.

ADDITIONAL INFORMATION

If more than one screen,  
show locations of each on sketch.