

MISSISSIPPI DEPARTMENT OF ENVIRONMENTAL QUALITY

Office of Land and Water Resources

P. O. Box 10631
Jackson, MS 39289-0631

WATER WELL DRILLERS LOG

COUNTY WELL LOCATED Tipton	
WELL NUMBER 2022	CODED
DATE WELL COMPLETED 4/5/96	

PERMIT NUMBER
NAME OF DRILLING FIRM Wilson well co

NAME & MAILING ADDRESS OF LANDOWNER June Baswell 1315 Jackson St Cornwall Ma			
WELL LOCATION:	SEC 4	TOWNSHIP 2	RANGE 4
DISTANCE	DIRECTION	NEAREST TOWN	
2 Miles	S	of Chalybeate	
OTHER LANDMARK			
WELL PURPOSE: <input checked="" type="radio"/> Home <input type="radio"/> Irrigation, <input type="radio"/> Municipal, <input type="radio"/> Industrial, <input type="radio"/> Fish Pond, etc.			

PUMP DATA		
PUMP TYPE (Circle One): <input checked="" type="radio"/> Submersible, <input type="radio"/> Turbine, <input type="radio"/> Jet <input type="radio"/> Flowing Well, Other (Describe) _____		
POWER TYPE (Circle One): <input checked="" type="radio"/> Electric, <input type="radio"/> Tractor, <input type="radio"/> Diesel, <input type="radio"/> Gasoline, <input type="radio"/> Butane, Other (Describe) _____ H/P 1 1/2		
Pump Capacity (GPM) 18	No. of Stages	Setting Depth 120 FT.
PUMP TEST		
Well yielded 18 GPM with a drawdown of _____ ft. after _____ hours of pumping		

WELL DATA		
Well Depth 127	Casing Diameter (In.) 4"	Casing Length (Ft.) 117
Type of Casing PVC	Hole Depth 135	Depth to Static Water Level 50'
TYPE OF COMPLETION: (Circle One or More): <input checked="" type="radio"/> Gravel Packed, <input type="radio"/> Underreamed, <input type="radio"/> Telescoped, <input type="radio"/> Natural Development, <input type="radio"/> Open Hole, <input type="radio"/> Other (Describe) _____		
WELL GROUTED TO A DEPTH OF _____ FEET Type Grout (circle one): Cement, Bentonite, or Mix		

LOG DATA	
TYPE OF LOG RUN (Circle One): <input type="radio"/> No Log Run, <input type="radio"/> Electric, <input type="radio"/> Gamma Ray, <input type="radio"/> Density, <input type="radio"/> Sonic, <input type="radio"/> Neutron, Other (Describe) _____	
Name of Organization Running Log	

SCREEN DATA		
Diameter - Inches 4"	Length - Feet 10'	Slot Size - Inches 010
Screen Type PVC slotted	Depth to Bottom - Feet 127	

GEOLOGIC DATA (Office Use Only)			
Surface Elev.	Geologic Unit	Unit Thickness	Depth to Top
Subs. SWL	Date	Analysis	Aquifer Test


Driller's Remarks
RECEIVED

DESCRIPTION OF FORMATIONS ENCOUNTERED	FROM	TO	FORMATIONS (Continued)	FROM	TO
Red sand	0	30	MAY 06 1996		
Red clay	30	40			
Blue clay	40	75			
Rock	75	77			
Blue clay	77	80			
Rock	80	88			
Blue clay	88	110			
Green sand	110	127			
Grey clay	127	135			

IF MORE SPACE IS NEEDED, USE BACK

If well telescopes please sketch and show depths.

GROUND LEVEL

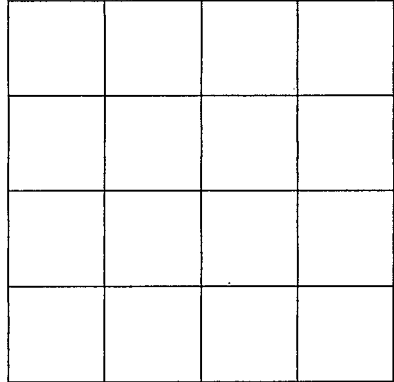

SECTION _____

Please indicate well location X.

ADDITIONAL INFORMATION

If more than one screen,
show location of each on sketch.