

Tippah
 E 11
 7-8-70

MISSISSIPPI
 BOARD OF WATER COMMISSIONERS
 416 North State Street
 Jackson, Mississippi 39201

CODED

WATER WELL DRILLERS LOG

Tippah
~~Bottom~~

7-8 19 70 date well completed Robert W. Wilson firm name Tippah county well located

LANDOWNER: Jessie Hopkins
Ashland
Miss
 (mailing address)

description of formations encountered	from	to
Red Clay Red sand	0	20
Red sand	20	100

WELL LOCATION:
 sec. 6 T. 3 N. R. 3 E
 (distance) (direction) (nearest town)

WELL PURPOSE:
 (home, irrigation, municipal, industrial)

WELL COMPLETION DATA:

- (1) diameter (inches) 4
- (2) total depth (feet) 100
- (3) static water level (feet) 90 below above top of ground.
- (4) casing plaster, 96 (material) (depth)
4 (size) if telescope see back.
- (5) screen 4, 96 (length) (depth to top)
4, Drummed Perch (size) (material)
- (6) pump 3/4, 10 (HP) (yield gpm)
Electric (type power)
- (7) electric log ✓ (yes or no)
- (organization running log) ✓

CODED

(8) how well bottom plugged plaster cap


JUL 21 1970

MISS. Bd OF WATER COMM.

DRILLERS REMARKS:

If well telescopes please sketch and show depths.

GROUND LEVEL

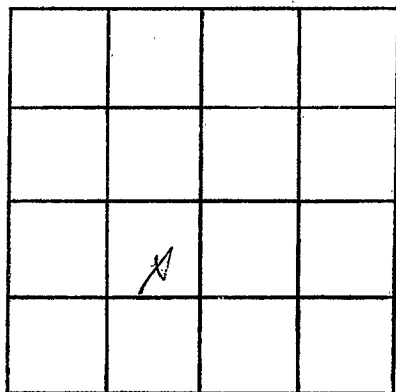

SECTION _____

Please indicate well location X.

ADDITIONAL INFORMATION

If more than one screen, show locations of each on sketch.