

Tippah
E12
5-67

MISSISSIPPI
BOARD OF WATER COMMISSIONERS
416 North State Street
Jackson, Mississippi 39201


CODED

WATER WELL DRILLERS LOG

May 3 1967 Jumper Well Co Tippah
date well completed firm name county well located


LANDOWNER:	description of formations encountered	from	to
Home Milard Ripley, Mississippi (mailing address)			
WELL LOCATION: sec 22 T 30 N R 3 E 5 miles S west of Falkville (distance) (direction) (nearest town)	SAND + MIXED CLAY 1	0	90
WELL PURPOSE: Home (home, irrigation, municipal, industrial)	MIXED CLAY 1	90	250
WELL COMPLETION DATA: (1) diameter (inches) 4 (2) total depth (feet) 320 (3) static water level (feet) 110 below above top of ground. (4) casing PVC, 120 (material), (depth) (size) if telescope see back. (5) screen 110 (length), (depth to top) (size), (material) (6) pump 1 HP, 100 (HP), (yield/gpm) Electric (type power) (7) electric log (yes or no) (organization running log) (8) how well bottom plugged	ROCK + SAND 250 320	250	320
DRILLERS REMARKS:			

CODED

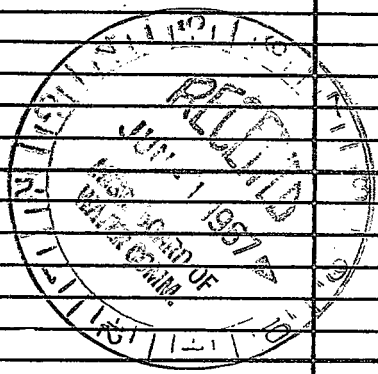

If well telescopes please sketch and show depths.

GROUND LEVEL

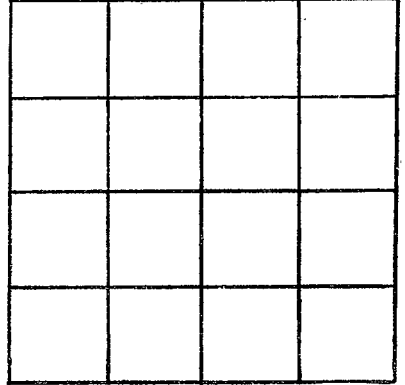

SECTION _____

Please indicate well location X.

ADDITIONAL INFORMATION

If more than one screen, show locations of each on sketch.