

Tippah
 7 E 13
 9-27-68

MISSISSIPPI
 BOARD OF WATER COMMISSIONERS
 416 North State Street
 Jackson, Mississippi 39201

INDEXED

INDEXED

WATER WELL DRILLERS LOG

9-27-1968 Layne-Central Company Tippah
 date well completed firm name county well located

LANDOWNER: Falkner Develop-
 ment Association, Falkner,
 Mississippi


description of formations encountered	from	to
Soft clay	0	25
sand	25	35
blue clay	35	45
rock	45	70
gumbo & rock	70	113
rock & sand st.	113	132
hard rock	132	137
sand, clay & rock	137	158
sand & rock st.	158	170
clay & rock	170	222
sand & clay	222	242
clay	242	252
sand & clay st.	252	297
hard gumbo	297	785
rock	785	788
sandy clay	788	818
sand & clay st.	818	828
clay & sand st.	828	845
sand & clay st.	845	859
hard clay	859	876
sand & clay	876	940

(mailing address)
 WELL LOCATION: SE 1/4
 sec. 1 T. 3 N R. 3 E
 (distance) miles of (direction) of (nearest town)

WELL PURPOSE: municipal
 (home, irrigation, municipal, industrial)

WELL COMPLETION DATA:
 (1) diameter (inches) 8"
 (2) total depth (feet) 915'
 (3) static water level (feet) 128' below above top of ground.
 (4) casing steel 847' (material), (depth), 8" (size) if telescope see back.
 (5) screen 62' 852' (length), (depth to top) 4" stainless Cook (size), (material)
 (6) pump 20 150 (HP), (yield gpm) electric (type power)
 (7) electric log (yes or no) (organization running log)
 (8) how well bottom plugged


INDEXED

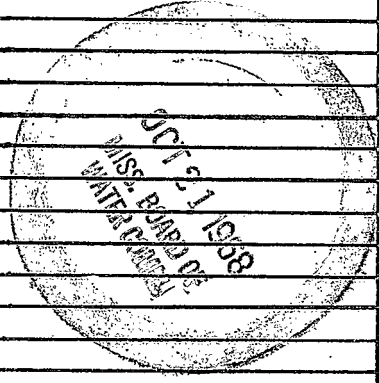

DRILLERS REMARKS:

If well telescopes please sketch and show depths.

GROUND LEVEL

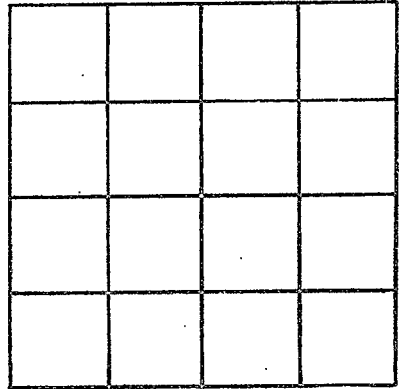

SECTION 1

Please indicate well location X.

ADDITIONAL INFORMATION

If more than one screen, show locations of each on sketch.