

TIPPAM
E 14
3-6-71

MISSISSIPPI
BOARD OF WATER COMMISSIONERS
416 North State Street
Jackson, Mississippi 39201

CODED

WATER WELL DRILLERS LOG

3-6 1971 J T Meekin Tippah
date well completed firm name county well located

LANDOWNER: Unity Baptist Church
H.P. Roberts Ripleys
(mailing address)

description of formations encountered	from to	
	feet	feet
<u>Red Clay</u>	0	18
<u>Marl</u>	18	145
<u>Blue Rock</u>	145	278
<u>Sand</u>	278	309
<u>Blue Sand</u>	309	319
<u>Blue Sand</u>	319	328
<u>Sand</u>	328	360

WELL LOCATION:
sec. 23 T. 3 N. R. 3 E
3 miles SW of Fallmor
(distance) (direction) (nearest town)

WELL PURPOSE: Church
(home, irrigation, municipal, industrial)

- WELL COMPLETION DATA:
- (1) diameter (inches) 4
 - (2) total depth (feet) 360
 - (3) static water level (feet) 180 below top of ground.
 - (4) casing P 195
(material) (depth)
(size) if telescope see back.
 - (5) screen _____
(length) (depth to top)
(size) (material)
 - (6) pump 1/2 3
(HP) (yield gpm)
(type power)
 - (7) electric log _____
(yes or no)
(organization running log)
 - (8) how well bottom plugged _____

CODED

APR - 6 1971

DRILLERS REMARKS:


MISS. DEPT. OF
WATER RESOURCES

If well telescopes please
sketch and show depths.

GROUND LEVEL



If more than one screen,
show locations of each on sketch.

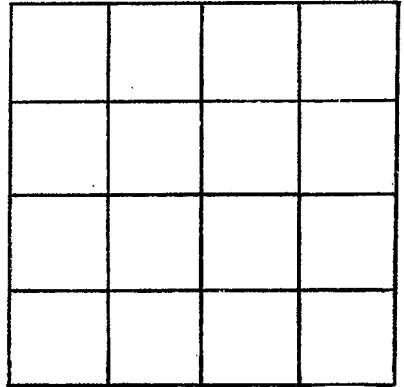

SECTION _____

Please indicate well location X.

ADDITIONAL INFORMATION

