

TIPPAH  
E 15  
4-29-71

MISSISSIPPI  
BOARD OF WATER COMMISSIONERS  
416 North State Street  
Jackson, Mississippi 39201

**CODED**

WATER WELL DRILLERS LOG

4-29-71 date well completed Robert W. Wilson firm name Tippah county well located

LANDOWNER:	description of formations encountered	from	to
Ashland	Red Clay L. 1 lb. clay	0	20
MISS	Blue Clay	20	60
(mailing address)	Blue Clay Rock white L. 1	60	80
WELL LOCATION:	White L. 1	80	96
sec. 22 T-3 N R-2 E			
(distance) miles (direction) of (nearest town)			
WELL PURPOSE:			
(home, irrigation, municipal, industrial)			
WELL COMPLETION DATA:			
(1) diameter (inches) 4			
(2) total depth (feet) 96			
(3) static water level (feet) 70 below top of ground.			
(4) casing Plastic 88 (material) (depth) 4 If telescope see back. (size)			
(5) screen 8 88 (length) (depth to top) 4 Draped Pack (size) (material)			
(6) pump 3/4 10 (HP) (yield gpm) Electric (type power)			
(7) electric log (yes or no) (organization running log)			
(8) how well bottom plugged 4" Plastic Cap			
DRILLERS REMARKS:			


**CODED**

JUN 3 1971

MISSISSIPPI  
BOARD OF WATER COMMISSIONERS

If well telescopes please  
sketch and show depths.

GROUND-LEVEL

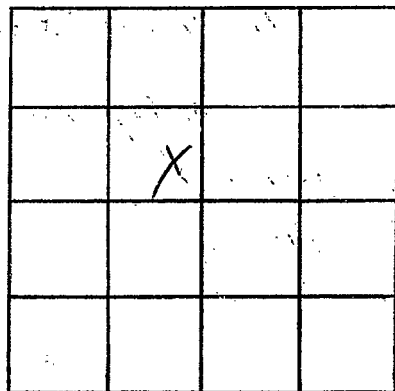

SECTION 22

Please indicate well location X.

ADDITIONAL INFORMATION

If more than one screen,  
show locations of each on sketch.