

# 950.00  
 45.00  
 \$ 795.00

**TIPPDAH**  
**E-17**  
**8-20-71**

MISSISSIPPI  
 BOARD OF WATER COMMISSIONERS  
 416 North State Street  
 Jackson, Mississippi 39201

**CODED**

WATER WELL DRILLERS LOG

8-20 date well completed 19 71 firm name *J T Medlin* county well located *Tippah*

LANDOWNER:	description of formations encountered	from	to
<i>Pearce Jackson</i>	<i>Clay</i>	<i>0</i>	<i>17</i>
<i>Falkner</i>	<i>Blue Clay</i>	<i>17</i>	<i>160</i>
	<i>Rock &amp; "</i>	<i>160</i>	<i>178</i>
	<i>Blue "</i>	<i>178</i>	<i>214</i>
	<i>Rock &amp; Sand</i>	<i>218</i>	<i>280</i>
(mailing address)			
WELL LOCATION: sec. <i>16</i> T. <i>3</i> R. <i>3</i> E. <i>4</i> miles <i>West</i> of <i>Falkner</i> (distance) (direction) (nearest town)			
WELL PURPOSE: (home, irrigation, municipal, industrial)			
WELL COMPLETION DATA:			
(1) diameter (inches) <i>4</i>			
(2) total depth (feet) <i>380</i>			
(3) static water level (feet) <i>86</i> below/above top of ground.			
(4) casing <i>P</i> <i>280</i> (material) (depth)			
(size) If telescope see back.			
(5) screen <i>20</i> <i>260</i> (length) (depth to top)			
<i>4</i> <i>P</i> (size) (material)			
(6) pump <i>1/2</i> <i>6</i> (HP) (yield gpm)			
<i>E</i> (type power)			
(7) electric log (yes or no)			
(organization running log)			
(8) how well bottom plugged <i>cap</i>			
DRILLERS REMARKS:			


**CODED**

SEP 8 1971

MISS. BD. OF  
 WATER COMMISSIONERS

If well telescopes please sketch and show depths.

GROUND LEVEL

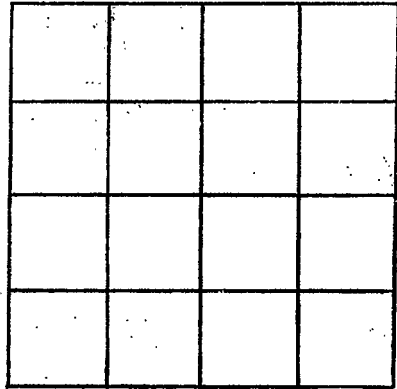

SECTION \_\_\_\_\_

Please indicate well location X.

ADDITIONAL INFORMATION

A series of horizontal lines for recording additional information, starting below the 'ADDITIONAL INFORMATION' header and extending to the bottom of the page.

If more than one screen, show locations of each on sketch.