

**TIPPAH**  
**E-18**  
**8-27-71**

MISSISSIPPI  
 BOARD OF WATER COMMISSIONERS  
 416 North State Street  
 Jackson, Mississippi 39201

1,100.00  
 55.00  
 1,155.00

**WATER WELL DRILLERS LOG**

*Tippah*

8 27 1971 date well completed  
 J. T. McElvin firm name  
 Tippah county/well located

LANDOWNER: *Thos Compton*  
*Ripley*  
 (mailing address)

WELL LOCATION:  
 sec. 14 T. 3 R. 2  
 4 miles *North W. Ripley*  
 (distance) (direction) (nearest town)

WELL PURPOSE:  
 (home, irrigation, municipal, industrial)

WELL COMPLETION DATA:

(1) diameter (inches) 4

(2) total depth (feet) 300

(3) static water level (feet) 160 below above top of ground.

(4) casing P 300  
 (material) (depth)  
 (size) if telescope see back.

(5) screen 20 140  
 (length) (depth to top)  
 (size) (material)

(6) pump 2 3  
 (HP) (yield gpm)  
E  
 (type power)

(7) electric log (yes or no)

(organization running log)

(8) how well bottom plugged Caps



Description of formations encountered	from	to
Clay	0	17
Sand	17	26
Blue Clay	26	145
Rock & sand	145	162
Blue Clay	162	275
Rock & sand	275	300

SEP 8 1971

MISS. BD. OF WATER COMMISSIONERS

DRILLERS REMARKS:

If well telescopes please sketch and show depths.

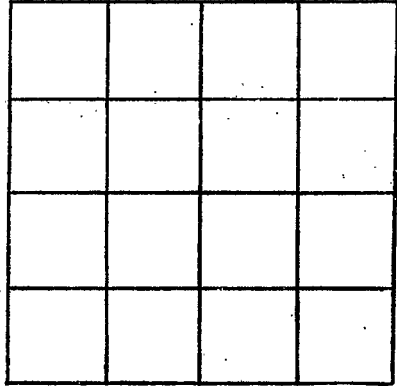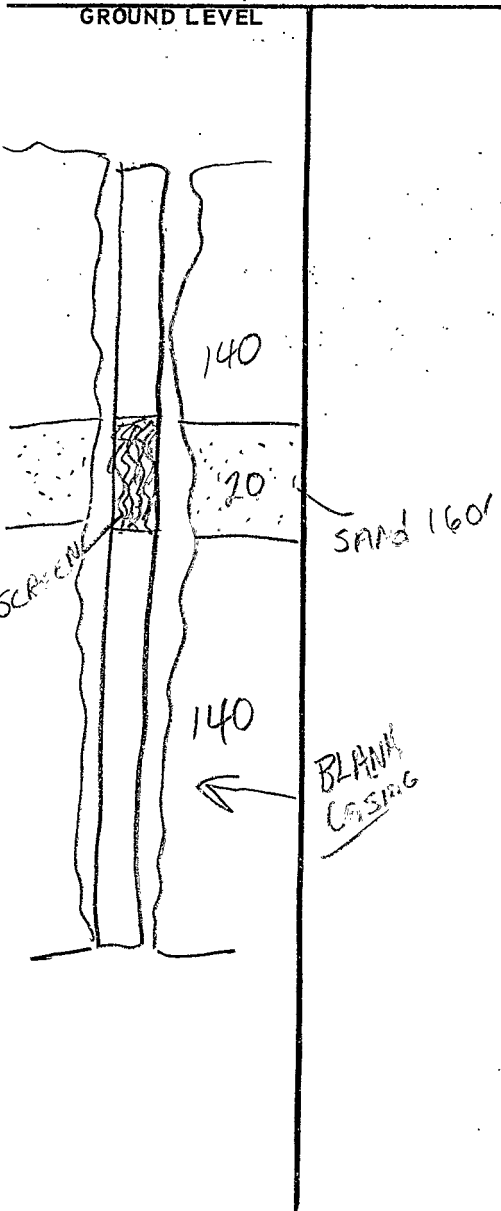

SECTION 14

Please indicate well location X.

ADDITIONAL INFORMATION

The static water level is very questionable and also location of well in hole.

J.C. Monroe  
9-13-71

If more than one screen, show locations of each on sketch.