


Tippah
E19
11-66

MISSISSIPPI
BOARD OF WATER COMMISSIONERS
416 North State Street
Jackson, Mississippi 39201

WATER WELL DRILLERS LOG

Nov. 16 19 66 George Wells Co. Tippah
date well completed firm name county well located

LANDOWNER:	description of formations encountered	from	to
(mailing address)			
<u>Eugene Johnson</u> <u>Falmer, Miss.</u>	<u>Mixed sand & clay</u>	<u>0</u>	<u>50</u>
<u>WELL LOCATION</u> sec. <u>5</u> T. <u>3</u> N. R. <u>3</u> E. S. <u>5</u> W.	<u>Clay</u>	<u>50</u>	<u>400</u>
<u>5</u> miles <u>west</u> of <u>Madison</u> (distance) (direction) (nearest town)	<u>sand & rock</u>	<u>400</u>	<u>480</u>
<u>WELL PURPOSE: Home</u> (home, irrigation, municipal, industrial)			
<u>WELL COMPLETION DATA:</u>			
(1) diameter (inches) <u>4"</u>			
(2) total depth (feet) <u>480'</u>			
(3) static water level (feet) <u>190'</u> below top of ground.			
(4) casing <u>PVC, 100'</u> <u>4"</u> (material), (depth) <u>4"</u> if telescope see back. (size)			
(5) screen <u>None</u> (length) (depth to top) (size) (material)			
(6) pump <u>2</u> <u>300 gph?</u> (HP) (yield gpm) <u>Electric</u> (type power)			
(7) electric log <u>No</u> (yes or no) <u>yes</u> (organization running log)			
(8) how well bottom plugged <u>None</u>			
<u>DRILLERS REMARKS:</u>			

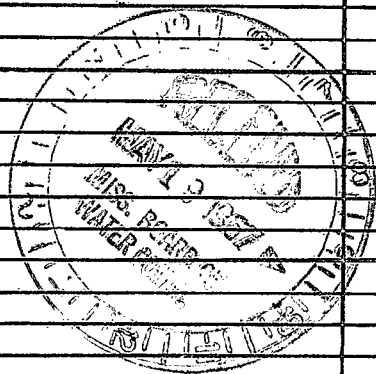

If well telescopes please sketch and show depths.

GROUND LEVEL

			X

SECTION _____

Please indicate well location X.

ADDITIONAL INFORMATION

If more than one screen,
show locations of each on sketch.