

TIPPAH
E 21
12-28-71

MISSISSIPPI
 BOARD OF WATER COMMISSIONERS
 416 North State Street
 Jackson, Mississippi 39201

WATER WELL DRILLERS LOG

CODED

date well completed 12-28-71 firm name Robert W. Wilson county well located Tipphah

LANDOWNER: Lee Roy Thacker
Ackland
Miss
 (mailing address)

WELL LOCATION:
 sec. 6 T. 3 N. R. 3E
 (distance) (direction) (nearest town)

WELL PURPOSE:
 (home, irrigation, municipal, industrial)

- WELL COMPLETION DATA:
- diameter (inches) 4
 - total depth (feet) 126
 - static water level (feet) 100 below top of ground.
 - casing Plastic 118
 (material) (depth)
4 if telescope see back.
 (size)
 - screen 8 118
 (length) (depth to top)
4 Horizontal Band
 (size) (material)
 - pump 3/4 10
 (HP) (yield gpm)
Electric
 (type power)
 - electric log ✓
 (yes or no)
- (organization running log)
- (8) how well bottom plugged Plastic

| description of formations encountered | from | to |
|---------------------------------------|------|-----|
| Red Clay Red Sand white Clay | 0 | 20 |
| Red Sand Rock Blue Clay | 20 | 40 |
| Blue Clay | 40 | 80 |
| Blue Clay Red yellow sand | 80 | 100 |
| yellow sand | 100 | 120 |
| white sand | 120 | 126 |


CODED

DRILLERS REMARKS:

FEB 3 1972

If well telescopes please sketch and show depths.

GROUND LEVEL

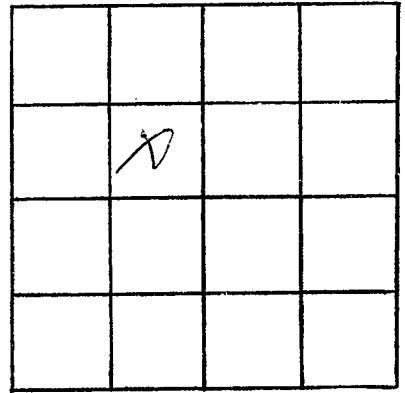

SECTION 6

Please indicate well location X.

ADDITIONAL INFORMATION

If more than one screen,
show locations of each on sketch.