

TIPPAH
E 22
6-6-72

MISSISSIPPI
BOARD OF WATER COMMISSIONERS
416 North State Street
Jackson, Mississippi 39201

CODED

WATER WELL DRILLERS LOG

6-6-72 19 date well completed
Jumper Well Drilling firm name
Tippan county well located

LANDOWNER: James W. Carter
Ripley, Miss. (mailing address)

description of formations encountered	from	to
thin clay	0	170
Sub + Rock	170	200

WELL LOCATION:
sec. 6 T 3 R 3 E
3 miles N E of Ripley
(distance) (direction) (nearest town)

WELL PURPOSE: Home
(home, irrigation, municipal, industrial)

- WELL COMPLETION DATA:
- (1) diameter (inches) 4 1/2
 - (2) total depth (feet) 200
 - (3) static water level (feet) 30 below top of ground
 - (4) casing PVC 100 (material) (depth)
 - (5) screen (size) 0 (length) 0 (depth to top)
 - (6) pump 1/2 (HP) 8 (yield gpm)
Elex (type power)
 - (7) electric log 0 (yes or no)
 - (8) how well bottom plugged 0

CODED


DEC 11 1972

MISS. BD. OF
WATER COM. LOG

DRILLERS REMARKS:

If well telescopes please sketch and show depths.

GROUND LEVEL

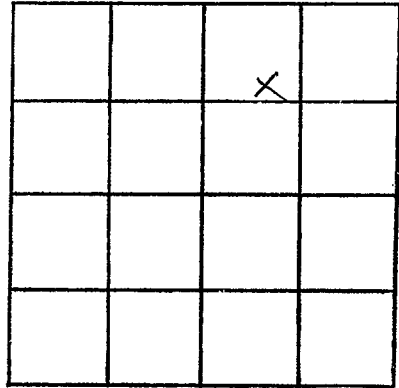

SECTION 6

Please indicate well location X.

ADDITIONAL INFORMATION

Lined area for additional information.

If more than one screen, show locations of each on sketch.