

E 23  
TIPPAH  
7-24-73

MISSISSIPPI  
BOARD OF WATER COMMISSIONERS  
416 North State Street  
Jackson, Mississippi 39201

800 00  
45 00  

---

845 00

WATER WELL DRILLERS LOG

7-24 19 73 J T Medlin Tippah  
date well completed firm name county/well located

LANDOWNER:  
Terry Kelcham  
Ripley  
(mailing address)

description of formations encountered	from	to
Clay	0	13
blue s.s.	13	25
rock sand	18	320

WELL LOCATION:  
sec 35 T 3 S R 3 E  
3 miles NE of Ripley  
(distance) (direction) (nearest town)

WELL PURPOSE:  
(home, irrigation, municipal, industrial)

WELL COMPLETION DATA:

(1) diameter (inches) 4

(2) total depth (feet) 320

(3) static water level (feet) 90 below above top of ground.

(4) casing P 100 (material) (depth)  
if telescope see back.  
(size)

(5) screen 0 (length) (depth to top)  
(size) (material)

(6) pump 5 6 (HP) (yield gpm)  
(type power)

(7) electric log (yes or no)  
(organization running log)

(8) how well bottom plugged


CODED

AUG 22 1973

DRILLERS REMARKS:

If well telescopes please sketch and show depths.

GROUND LEVEL

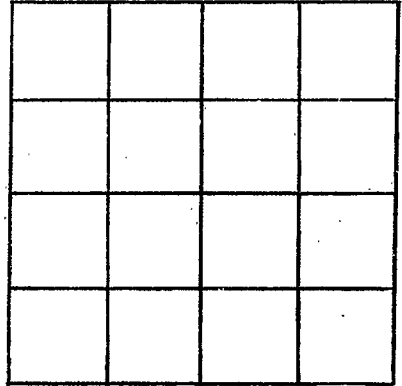

SECTION \_\_\_\_\_

Please indicate well location X.

ADDITIONAL INFORMATION

If more than one screen, show locations of each on sketch.