

**TIPPAN**  
**E 24**  
**3-17-75**

MISSISSIPPI  
 BOARD OF WATER COMMISSIONERS  
 416 North State Street  
 Jackson, Mississippi 39201

CODED

WATER WELL DRILLERS LOG

MARCH 17 1975 Billy R. SIMPSON TIPPAN  
 date well completed firm name county well located

LANDOWNER:  
ENOCH L. RUCKER  
Ripley, Miss  
 (mailing address)

description of formations encountered	from	to
SURFACE CHAY	0	17
SAND	17	44
ROCK	44	47
Blue CHAY	47	48

WELL LOCATION:  
 sec. 32 T 3 R. 3E  
3 miles N of Ripley  
 (distance) (direction) (nearest town)

THIS WELL WAS  
 DRILLED BELOW THIS  
 POINT AS FOLLOWS

WELL PURPOSE: HOME  
 (home, irrigation, municipal, industrial)

Blue CHAY	48	90
LIME STONE + SAND	90	170

WELL COMPLETION DATA:

(1) diameter (inches) 4

(2) total depth (feet) 48

(3) static water level (feet) 17 below above top of ground.

(4) casing POC 38  
 (material) (depth)  
 (size) if telescope see back.

(5) screen 10' 38  
 (length) (depth to top)  
4" POC  
 (size) (material)

(6) pump 3/4 10  
 (HP) (yield gpm)  
ELEC  
 (type power)

(7) electric log NO  
 (yes or no)  
 (organization running log)

(8) how well bottom plugged POC  
CMP


CODED

APR 7 1975  
 MISS. BD. OF WATER COMM

DRILLERS REMARKS: THIS WELL  
 PUMPED @ 15 G.P.M FOR  
 31 HOURS ON OPEN  
 DISCHARGE

If well telescopes please sketch and show depths.

GROUND LEVEL

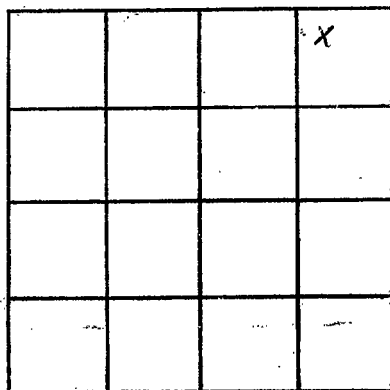

SECTION 32

Please indicate well location X.

ADDITIONAL INFORMATION

If more than one screen,  
show locations of each on sketch.