

E 25
 Tippah
 4/29/75

MISSISSIPPI
 BOARD OF WATER COMMISSIONERS
 416 North State Street
 Jackson, Mississippi 39201

CODED

WATER WELL DRILLERS LOG

427 1975 J.T. Walker Tippah
 date well completed firm name county/well located

LANDOWNER: Charles
 Robin Fulmer
 Rt 9
 (mailing address)

description of formations encountered		from	to
Clay		0	18
blue clay		18	240
rock & sand		240	330

WELL LOCATION:
 sec. 5 T 3 N R 3 E
 5 miles W of Fulmer
 (distance) (direction) (nearest town)

WELL PURPOSE:
 (home, irrigation, municipal, industrial)

WELL COMPLETION DATA:

(1) diameter (inches) 4.250

(2) total depth (feet) 350

(3) static water level (feet) 130 below top of ground.

(4) casing P 120 (material) (depth)

(size) if telescope see back.

(5) screen (length) (depth to top)

(size) (material)

(6) pump 6 (HP) (yield gpm)


(type power)

(7) electric log (yes or no)

(organization running log)

(8) how well bottom plugged

CODED

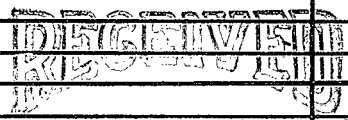


MAY 27 1975

DRILLERS REMARKS:

If well telescopes please sketch and show depths.

GROUND LEVEL

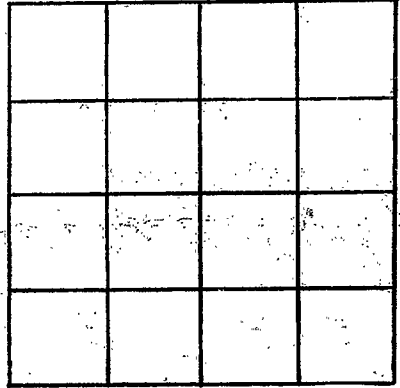

SECTION _____

Please indicate well location X.

ADDITIONAL INFORMATION

If more than one screen, show locations of each on sketch.