

Tippah  
E 2001  
4-22-76

MISSISSIPPI  
BOARD OF WATER COMMISSIONERS  
416 North State Street  
Jackson, Mississippi 39201

WATER WELL DRILLERS LOG

APRIL 22 1976 *Billy R. Simpson* TIPPAAH  
date well completed firm name county well located

LANDOWNER:  
*DORRICE ALLEN*  
*Ripley Miss*  
(mailing address)

WELL LOCATION:  
sec. 4 T. 3 R. 3  
4 miles SW of FALKNER  
(distance) (direction) (nearest town)

WELL PURPOSE: HOME  
(home, irrigation, municipal, industrial)

- WELL COMPLETION DATA:
- (1) diameter (inches) 4
  - (2) total depth (feet) 325
  - (3) static water level (feet) 158 below top of ground.
  - (4) casing PC 156  
(material) (depth)  
(size) If telescope see back.
  - (5) screen None  
(length) (depth to top)  
(size) (material)
  - (6) pump 1 1/2 JET 5  
(HP) (yield gpm)  
Elec  
(type power)
  - (7) electric log No  
(yes or no)  
(organization running log)
  - (8) how well bottom plugged


description of formations encountered	from	to
SOAPSTONE CLAY	0	35
Blue CLAY	35	46
ROCK	46	47
Blue CLAY	47	171
ROCK + SAND	171	173
Blue CLAY	173	195
LIMESTONE + SAND	195	225
Blue CLAY	225	264
LIMESTONE + SAND	264	325

DRILLERS REMARKS: SOAPSTONE CLAY  
CAVED SO BAD - WE HAD TO CASE  
IT OFF WITH 26 FT OF  
8 IN. CASING

RECEIVED  
TAX  
ADD 0.9 1976

If well telescopes please sketch and show depths.

GROUND LEVEL

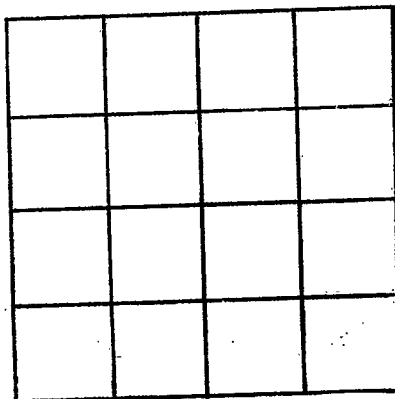

SECTION \_\_\_\_\_

Please indicate well location X.

ADDITIONAL INFORMATION

If more than one screen, show locations of each on sketch.