

Tippah  
 E 2000  
 7-12-76

MISSISSIPPI  
 BOARD OF WATER COMMISSIONERS  
 416 North State Street  
 16L Jackson, Mississippi 39201

WATER WELL DRILLERS LOG

July 12 1976 date well completed  
 Billy R. Simpson firm name  
 TIPPAH county well located

LANDOWNER:  
 JOHN BEAVERS  
 FALKNER, MISS  
 (mailing address)

WELL LOCATION:  
 sec. 22 T 3 S R 3 E  
 4 miles SW of FALKNER  
 (distance) (direction) (nearest town)

WELL PURPOSE: HOUSING  
 (home, irrigation, municipal, industrial)

WELL COMPLETION DATA:

(1) diameter (inches) 4

(2) total depth (feet) 330

(3) static water level (feet) 130 below ground

(4) casing PVC 172 (material) (depth)

(size) if telescope see back.

(5) screen None (length) (depth to top)

(size) (material)

(6) pump 3/4 (HP) 10 (yield gpm)

ELEC. (type power)

(7) electric log No (yes or no)

(organization running log)

(8) how well bottom plugged


description of formations encountered	from	to
SURFACE CLAY	0	3
SOAPSTONE CLAY	3	35
Blue CLAY	35	41
ROCK	41	42
Blue CLAY	42	158
ROCK	158	159
SAND	159	164
Blue CLAY	164	178
ROCK, CLAY + SAND	178	209
Blue CLAY	209	246
LIMESTONE + SAND	246	330

RECEIVED  
 SEP - 9 1976  
 MISS. BD. OF WATER COMM.

DRILLERS REMARKS:

If well telescopes please sketch and show depths.

GROUND LEVEL

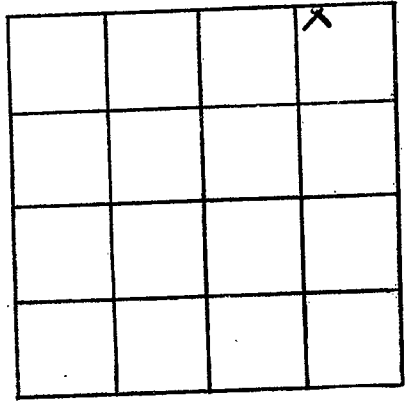

SECTION 22

Please indicate well location X.

ADDITIONAL INFORMATION

If more than one screen, show locations of each on sketch.