

Tippah
E 2003
8-8-76

MISSISSIPPI
BOARD OF WATER COMMISSIONERS
416 North State Street
Jackson, Mississippi 39201

WATER WELL DRILLERS LOG

Aug 18 1976
date well completed

15F Billy R. Simpson
firm name

TIPPANH
county well located

LANDOWNER:
CHAS. MEEKS
RIPLEY MISS
(mailing address)

WELL LOCATION:
sec. 34 T 3 R 2 E
8 miles NW of RIPLEY
(distance) (direction) (nearest town)

WELL PURPOSE: HOAC
(home, irrigation, municipal, industrial)

| description of formations encountered | from | to |
|---------------------------------------|------|-----|
| SURFACE CLAY | 0 | 4 |
| SAND + CLAY | 4 | 20 |
| WHITE CLAY | 20 | 29 |
| ROCK | 29 | 30 |
| FINE SAND + WHITE CLAY | 30 | 110 |
| BLUE CLAY | 110 | 235 |
| SAND | 235 | 248 |
| LIMESTONE + SAND | 241 | 295 |
| BLUE CLAY | 295 | 324 |
| LIMESTONE + SAND | 324 | 358 |

WELL COMPLETION DATA:

(1) diameter (inches) 4

(2) total depth (feet) 358

(3) static water level (feet) 35 below top of ground.

(4) casing PCC 120 (material) (depth)

(size) if telescope see back.

(5) screen NONE (length) (depth to top)

(size) (material)

(6) pump 1/2 6 (HP) (yield gpm)

Elec (type power)

(7) electric log NO (yes or no)

(organization running log)

(8) how well bottom plugged


RECEIVED
SEP - 9 1976

MISS. BD. OF WATER COMMISSIONERS

DRILLERS REMARKS:

If well telescopes please sketch and show depths.

GROUND LEVEL

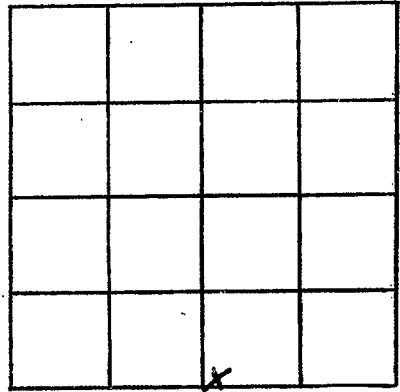

SECTION 34

Please indicate well location X.

ADDITIONAL INFORMATION

If more than one screen,
show locations of each on sketch.