

Tippah  
 E 3004  
 11/19/76

MISSISSIPPI  
 BOARD OF WATER COMMISSIONERS  
 416 North State Street  
 Jackson, Mississippi 39201

WATER WELL DRILLERS LOG

1800 19 19 76 Billy R. Simpson TIPPAH  
 date well completed firm name county well located

LANDOWNER:  
JOHNNY WICKBARKS  
RIPLEY MISS  
 (mailing address)

description of formations encountered	from	to
<u>SURFACE CLAY</u>	<u>0</u>	<u>10</u>
<u>YELLOW CLAY</u>	<u>10</u>	<u>22</u>
<u>Blue CLAY</u>	<u>22</u>	<u>117</u>
<u>ROCK</u>	<u>117</u>	<u>118</u>
<u>Blue CLAY</u>	<u>118</u>	<u>121</u>
<u>LIMESTONE + SAND</u>	<u>121</u>	<u>169</u>
<u>Blue CLAY</u>	<u>169</u>	<u>208</u>
<u>LIMESTONE + SAND</u>	<u>208</u>	<u>300</u>

WELL LOCATION:  
 sec. 33 T. 3 N. R. 3 E.  
4 miles NW of RIPLEY  
 (distance) (direction) (nearest town)

WELL PURPOSE: Home  
 (home, irrigation, municipal, industrial)

WELL COMPLETION DATA:

(1) diameter (inches) 4

(2) total depth (feet) 300

(3) static water level (feet) 58 below above top of ground.

(4) casing POC, 115',  
 (material) (depth)  
 (size) if telescope see back.

(5) screen None  
 (length) (depth to top)  
 (size) (material)

(6) pump 1/2 10  
 (HP) (yield gpm)  
FLC  
 (type power)

(7) electric log NO  
 (yes or no)  
 (organization running log)

(8) how well bottom plugged None


DRILLERS REMARKS:

**RECEIVED**

DEC 29 1976

If well telescopes please sketch and show depths.

GROUND LEVEL

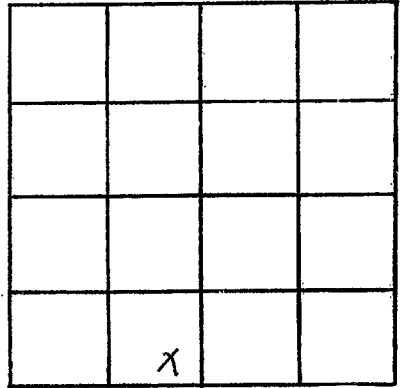

SECTION 93

Please indicate well location X.

ADDITIONAL INFORMATION

If more than one screen,  
show locations of each on sketch.