

Tippah  
E 2005  
11-28-76

MISSISSIPPI  
BOARD OF WATER COMMISSIONERS  
416 North State Street  
Jackson, Mississippi 39201

WATER WELL DRILLERS LOG

11/28/76 date well completed  
Medison Well Drilling firm name  
Tippah county well located


LANDOWNER: <u>BENCHIL'S</u>	description of formations encountered	from	to
<u>Ripley Ms.</u> (mailing address)	<u>Clay</u> <u>sand</u>	<u>0</u> <u>20</u>	<u>20</u> <u>200</u> <u>20</u>
WELL LOCATION: SEC <u>25</u> T <u>8</u> N R <u>30</u> E <u>North</u> miles <u>North</u> of <u>Ripley</u> (distance) (direction) (nearest town)	<u>Clay</u> <u>Blue mud</u> <u>sand &amp; rock</u>	<u>70</u> <u>175</u> <u>390</u>	<u>175</u> <u>390</u> <u>450</u>
WELL PURPOSE: (home, irrigation, municipal, industrial)			
WELL COMPLETION DATA: (1) diameter (inches) <u>4"</u> (2) total depth (feet) <u>450</u> (3) static water level (feet) <u>110</u> <sup>below</sup> <sub>above</sub> top of ground. (4) casing <u>Plastic</u> <u>220'</u> (material) (depth) (size) If telescope see back. (5) screen (length) (depth to top) (size) (material) (6) pump <u>1/2</u> <u>9</u> (HP) (yield gpm) <u>elec</u> (type power) (7) electric log (yes or no) (organization running log) (8) how well bottom plugged			
DRILLERS REMARKS:			

**RECEIVED**  
MAY 13 1977

MISS. BD. OF WATER COMMISSIONERS

If well telescopes please  
sketch and show depths.

GROUND LEVEL

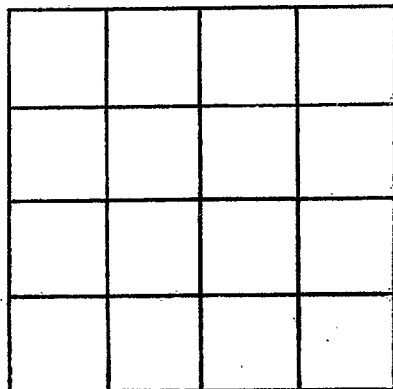

SECTION \_\_\_\_\_

Please indicate well location X.

ADDITIONAL INFORMATION

If more than one screen,  
show locations of each on sketch.