

Tippah
 E 2000
 3-26-77

MISSISSIPPI
 BOARD OF WATER COMMISSIONERS
 416 North State Street
 Jackson, Mississippi 39201

WATER WELL DRILLERS LOG

3-26 1977 Melvin Well Drilling Tippah
 date well completed firm name county well located

LANDOWNER: JOE Shelton
~~Richard A. S.~~
Falkner Mc.
 (mailing address)

description of formations encountered	depth	
	from	to
Clay	0	20
Mixed Clay & Rock	20	50
Blue Clay	50	150
Sand & Rock	150	240

WELL LOCATION:
 sec. 2 T. 3 N. R. 3 E.
3 1/2 miles 1/2 North of Falkner
 (distance) (direction) (nearest town)

WELL PURPOSE:
 (home, irrigation, municipal, industrial)


- WELL COMPLETION DATA:
- (1) diameter (inches) 4
 - (2) total depth (feet) 240
 - (3) static water level (feet) 60 ^{below} _{above} top of ground.
 - (4) casing Plas. 105
 (material) (depth)
 (size) if telescope see back.
 - (5) screen _____
 (length) (depth to top)
 (size) 1 (material) 8
 - (6) pump 1/2 8
 (HP) (yield gpm)
elec.
 (type power)
 - (7) electric log (yes or no) _____
 (organization running log) _____
 - (8) how well bottom plugged Open.

DRILLERS REMARKS:

RECEIVED
 AUG 22 1977
 MISS. BD. OF WATER COMMISSIONERS

If well telescopes please sketch and show depths.

GROUND LEVEL

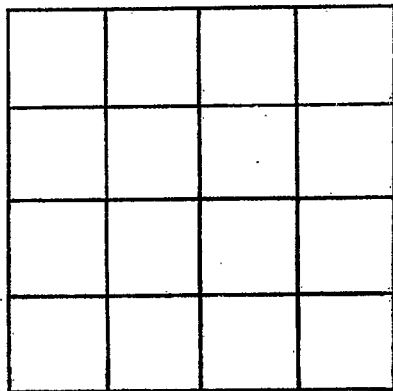

SECTION _____

Please indicate well location X.

ADDITIONAL INFORMATION

If more than one screen, show locations of each on sketch.