

TIPPAH
E 2008
7-29-78

**MISSISSIPPI  
BOARD OF WATER COMMISSIONERS**  
416 North State Street  
Jackson, Mississippi 39201

**WATER WELL DRILLERS LOG**

July 29, 1978 Billy R. Scarpson TIPPAH  
 date well completed                      firm name                      county well located

**LANDOWNER:**  
DONALD Sills  
Ripley Ms.  
 (mailing address)

description of formations encountered	from	to
	⊙	5'
SURFACE CLAY	0	5'
SAND	5	45
YELLOW CLAY	45	50
Blue CLAY	50	187
LIMESTONE & SAND	187	240
Blue CLAY	240	278
LIMESTONE	278	339

**WELL LOCATION:**  
 sec. 32 T 3 S R 3 E  
5 miles W of Ripley  
 (distance) (direction) (nearest town)

**WELL PURPOSE:** Home  
 (home, irrigation, municipal, industrial)

**WELL COMPLETION DATA:**

(1) diameter (inches) 4

(2) total depth (feet) 339

(3) static water level (feet) 105 below above top of ground.

(4) casing Pvc 141  
 (material) (depth)  
 (size) if telescope see back.

(5) screen None  
 (length) (depth to top)

(6) pump 1/2 Jet 10  
 (HP) (yield gpm)  
Elec  
 (type power)

(7) electric log No  
 (yes or no)

(organization running log)

(8) how well bottom plugged None


**DRILLERS REMARKS:**

**RECEIVED**  
 SEP - 1 1978

MISS. BD. OF WATER COMM

If well telescopes please sketch and show depths.

GROUND LEVEL

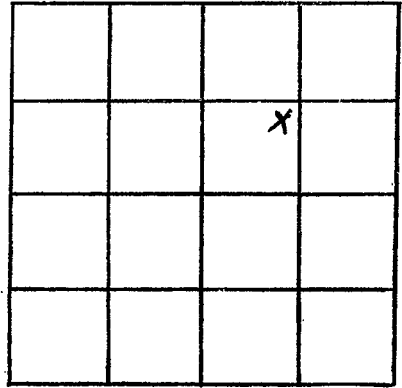

SECTION 32

Please indicate well location X.

ADDITIONAL INFORMATION

If more than one screen,  
show locations of each on sketch.