

TIPPAH
E 2010
7/16/79

MISSISSIPPI
BOARD OF WATER COMMISSIONERS
416 North State Street
Jackson, Mississippi 39201

WATER WELL DRILLERS LOG

July 16 1979 Billy R. Simpson TIPPAH
date well completed firm name county well located

LANDOWNER:
PHILIP NANCE
RIPLEY MS
(mailing address)

description of formations encountered	from	to
SURFACE CLAY	0	4
SOAPSTONE & SAND	4	20
LIENITE	20	25
BLUE CLAY	25	118
LIMESTONE & SAND	118	182
BLUE CLAY	182	188
LIMESTONE & SAND	188	230
Blue Clay	230	233
LIMESTONE	233	238

WELL LOCATION:
sec. 35 T 3 N^r R 2 E
8 miles W of RIPLEY
(distance) (direction) (nearest town)

WELL PURPOSE: Home
(home, irrigation, municipal, industrial)

WELL COMPLETION DATA:

(1) diameter (inches) 4

(2) total depth (feet) 238

(3) static water level (feet) 15 below above top of ground.

(4) casing Pvc 80
(material) (depth)

(size) If telescope see back.

(5) screen None
(length) (depth to top)

(size) (material)
(6) pump 1/2 10
(HP) (yield gpm)

Elec
(type power)

(7) electric log No
(yes or no)

(organization running log)

(8) how well bottom plugged None

Miss. Board of Water Comm.


AUG 14 1979

RECEIVED

DRILLERS REMARKS:

If well telescopes please sketch and show depths.

GROUND LEVEL

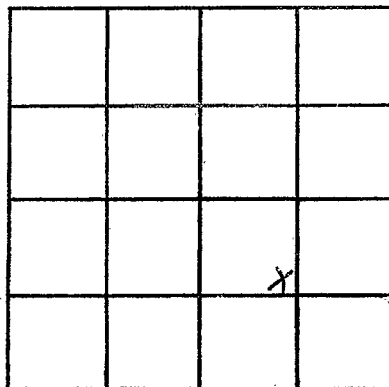

SECTION 35

Please indicate well location X.

ADDITIONAL INFORMATION

If more than one screen, show locations of each on sketch.