

Tippah
E 2012
9-22-80

MISSISSIPPI
BOARD OF WATER COMMISSIONERS
416 North State Street
Jackson, Mississippi 39201

WATER WELL DRILLERS LOG

Sept 22 1980 date well completed Billy R. Simpson firm name Tippah county well located

LANDOWNER:
RANAE HUDDLESTON
RIPLEY MISS
(mailing address)

description of formations encountered	from	to
SURFACE CLAY	0	10
SAND & CLAY	10	46
BLUE CLAY	46	229
LIMESTONE	229	281
BLUE CLAY	281	315
LIMESTONE & SAND	315	355

WELL LOCATION:
sec 35 T 5 R 2 E
8 miles NW of Ripley
(distance) (direction) (nearest town)

WELL PURPOSE: Home
(home, irrigation, municipal, industrial)

WELL COMPLETION DATA:

(1) diameter (inches) 4

(2) total depth (feet) 355

(3) static water level (feet) 40 below top of ground

(4) casing PVC 100 (material) (depth)

(size) if telescope see back.

(5) screen NONE (length) (depth to top)

(size) (material)

(6) pump 1/2 20 (HP) (yield gpm)

ELCC (type power)

(7) electric log NO (yes or no)

(organization running log)

(8) how well bottom plugged NONE

DEPT. OF NATURAL RESOURCES
BUREAU OF LAND & WATER RESOURCES


OCT 17 1980

RECEIVED

DRILLERS REMARKS:

If well telescopes please sketch and show depths.

GROUND LEVEL

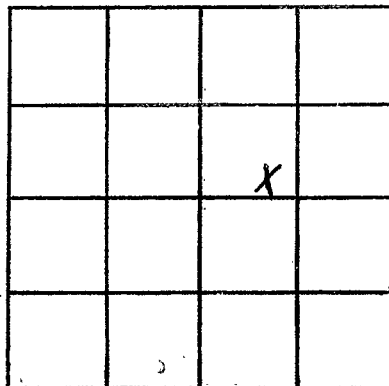

SECTION 35

Please indicate well location X.

ADDITIONAL INFORMATION

If more than one screen, show locations of each on sketch.