

Tippah
E 2013
2/20/81

MISSISSIPPI
BOARD OF WATER COMMISSIONERS
416 North State Street
Jackson, Mississippi 39201

WATER WELL DRILLERS LOG

FEB 20 1981 Billy R. Simpson TIPPDAH
date well completed firm name county well located

LANDOWNER:
PHIL TIDWELL
RIPLEY MISS
(mailing address)

description of formations encountered	from	to
SURFACE CLAY	0	8
SAND	8	15
ROCK	15	16
Blue CLAY	16	125
LIMESTONE & SAND	125	173
Blue CLAY	173	214
LIMESTONE & SAND	214	304

WELL LOCATION:
sec. 23 T. 3 N R. 3 E
4 miles N of RIPLEY
(distance) (direction) (nearest town)

WELL PURPOSE: Home
(home, irrigation, municipal, industrial)

- WELL COMPLETION DATA:
- diameter (inches) 4
 - total depth (feet) 304
 - static water level (feet) 61 below top of ground
 - casing PVC 110 (material) (depth)
4 (size) If telescope see back.
 - screen NONE (length) (depth to top)
(size) (material)
 - pump (HP) (yield gpm)
(type power)
 - electric log (yes or no)
(organization running log)
 - how well bottom plugged


DRILLERS REMARKS:
OWNER INSTALLED HIS OWN PUMP

DEPT. OF NATURAL RESOURCES
BUREAU OF LAND & WATER RESOURCES

APR 20 1981
RECEIVED

If well telescopes please sketch and show depths.

GROUND LEVEL

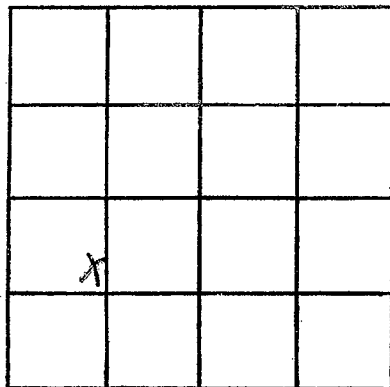

SECTION 23

Please indicate well location X.

ADDITIONAL INFORMATION

If more than one screen, show locations of each on sketch.