

MISSISSIPPI DEPARTMENT OF NATURAL RESOURCES

Bureau of Land and Water Resources

Southport Mall

P.O. Box 10631

Jackson, Mississippi 39209

WATER WELL DRILLERS LOG

Tippah
E
2017

SEPT 20 1984

Billy R Simpson

TIPPDAH

date well completed

firm name

county well located

LANDOWNER:
JAMES C. THOMAS
ASHLAND, MISS
 (mailing address)

WELL LOCATION:
 sec. 22 T 3 S R. 2 E
6 miles E of ASHLAND
 (distance) (direction) (nearest town)

WELL PURPOSE: HOME
 (home, irrigation, municipal, industrial)

WELL COMPLETION DATA:

(1) diameter (inches) 4

(2) total depth (feet) 128

(3) static water level (feet) 56 below above top of ground.

(4) casing POC 118
 (material) (depth)
 _____ if telescope see back.
 (size)

(5) screen 10 118
 (length) (depth to top)
4 POC .010
 (size) (material)

(6) pump 1 JET 8
 (HP) (yield gpm)
ELEC
 (type power)

(7) electric log No
 (yes or no)

 (organization running log)

(8) how well bottom plugged POC
cap

description of formations encountered	from	to
<u>SURFACE CLAY</u>	<u>0</u>	<u>6</u>
<u>RED SAND</u>	<u>6</u>	<u>26</u>
<u>YELLOW & WHITE CLAY</u>	<u>26</u>	<u>55</u>
<u>CLAY & FINE SAND</u>	<u>55</u>	<u>74</u>
<u>FINE SAND</u>	<u>74</u>	<u>87</u>
<u>WHITE CLAY</u>	<u>87</u>	<u>110</u>
<u>FINE SAND</u>	<u>110</u>	<u>128</u>
<u>WHITE CLAY</u>	<u>128</u>	<u>133</u>
<u>FINE SAND</u>	<u>133</u>	<u>150</u>
<u>BLUE CLAY</u>	<u>150</u>	

DRILLERS REMARKS:


DEPT. OF NATURAL RESOURCES
 BUREAU OF LAND & WATER RESOURCES

OCT 11 1984

RECEIVED

If well telescopes please sketch and show depths.

GROUND LEVEL

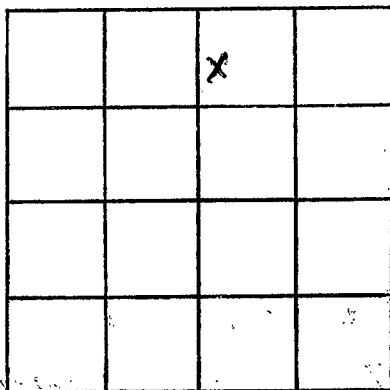

SECTION 22

Please indicate well location X.

ADDITIONAL INFORMATION

If more than one screen, show locations of each on sketch.