

# MISSISSIPPI DEPARTMENT OF NATURAL RESOURCES

Bureau of Land and Water Resources

P.O. Box 10631

Jackson, Mississippi 39209

## WATER WELL DRILLERS LOG

COUNTY WELL LOCATED <b>Tippah</b>	
WELL NUMBER <b>E</b>	CODED
<b>2221</b>	
DATE WELL COMPLETED <b>1-13-89</b>	

PERMIT NUMBER
NAME OF DRILLING FIRM <b>Wilson Well Co Inc</b>

NAME & MAILING ADDRESS OF LANDOWNER <b>Barry Morrow</b>			
<b>Rt 1 Box 90</b>			
<b>Ashland MS 38603</b>			
WELL LOCATION:	SEC	TOWNSHIP	RANGE
	<b>22</b>	<b>T3</b>	<b>R2</b>
		<b>N</b>	<b>E</b>
		<b>S</b>	<b>W</b>
DISTANCE	DIRECTION	NEAREST TOWN	
<b>6</b> Miles	<b>West</b>	<b>of Falkner</b>	
OTHER LANDMARK			
WELL PURPOSE: Home, Irrigation, Municipal, Industrial, Fish Pond, etc. <b>Home</b>			

PUMP DATA			
PUMP TYPE (Circle One): <u>Submersible</u> , Turbine, Jet, Flowing Well, Other (Describe)			
POWER TYPE (Circle One): <u>Electric</u> , Tractor, Diesel, Gasoline, Butane, Other (Describe)			
Pump Capacity (GPM)	No. of Stages	Setting Depth	
<b>10</b>	<b>15</b>	<b>55</b> FT.	
PUMP TEST			
Well yielded _____ GPM with a drawdown of _____ ft. after _____ hours of pumping			

WELL DATA			
Well Depth <b>60</b>	Casing Diameter (In.) <b>4</b>	Casing Length (Ft.) <b>40</b>	
Type of Casing <b>PVC</b>	Hole Depth <b>60</b>	Depth to Static Water Level <b>15</b>	
TYPE OF COMPLETION: (Circle One or More): <u>Gravel Packed</u> , Underreamed, Telescoped, Natural Development, Open Hole, Other (Describe)			
Top of Lap Pipe or Reduction in Casing			
FEET		IF TELESCOPED OR MORE THAN ONE SCREEN: USE BACK PAGE	

LOG DATA	
TYPE OF LOG RUN (Circle One): <u>No Log Run</u> , Electric, Gamma Ray, Density, Sonic, Neutron, Other (Describe)	
Name of Organization Running Log	

SCREEN DATA		
Diameter - Inches <b>4</b>	Length - Feet <b>10</b>	Slot Size - Inches <b>.010</b>
Screen Type <b>PVC</b>		Depth to Bottom - Feet <b>50</b>


GEOLOGIC DATA (Office Use Only)			
Surface Elev.	Geologic Unit	Unit Thickness	Depth to Top
Subs. SWL	Date	Analysis	Aquifer Test
Driller's Remarks <b>10' Blank at Bottom</b>			

DESCRIPTION OF FORMATIONS ENCOUNTERED	FROM	TO	FORMATIONS (Continued)	FROM	TO
<b>Red Clay</b>	<b>0</b>	<b>10</b>	<div style="font-size: 2em; font-weight: bold; opacity: 0.5;">DRILLER'S SIGNATURE</div> <div style="font-size: 1.5em; font-weight: bold; margin-top: 10px;">JAN 30 1989</div> <div style="font-size: 0.8em; margin-top: 10px;">Department of Natural Resources Bureau of Land &amp; Water Resources</div>		
<b>Red Sand + white sand</b>	<b>10</b>	<b>15</b>			
<b>White Sand</b>	<b>15</b>	<b>30</b>			
<b>White Sand</b>	<b>30</b>	<b>45</b>			
<b>White Sand</b>	<b>45</b>	<b>50</b>			
<b>White Clay</b>	<b>50</b>	<b>60</b>			

IF MORE SPACE IS NEEDED, USE BACK

If well telescopes please sketch and show depths.

GROUND LEVEL

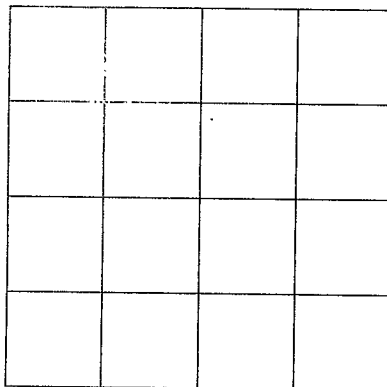

SECTION \_\_\_\_\_

Please indicate well location X.

ADDITIONAL INFORMATION

If more than one screen, show location of each on sketch.