

MISSISSIPPI  
 BOARD OF WATER COMMISSIONERS  
 416 North State Street  
 Jackson, Mississippi 39201

CODED

WATER WELL DRILLERS LOG

Lippah  
711  
4-29-68

April 29 1968 George Well Co. Lippah  
 date well completed firm name county well located

LANDOWNER: \_\_\_\_\_  
A. C. Rainey  
Ripley, Miss  
 (mailing address)

description of formations encountered	from	to

WELL LOCATION:  
 sec. 25 T. 3 N. R. 4 E.  
5 east <sup>SW</sup>  
Two miles west of Ripley  
 (distance) (direction) (nearest town)

<u>rippl sand &amp; clay</u>	<u>0</u>	<u>100</u>
------------------------------	----------	------------

WELL PURPOSE: Home  
 (home, irrigation, municipal, industrial)

WELL COMPLETION DATA:

(1) diameter (inches) 4

(2) total depth (feet) 180

(3) static water level (feet) 90 below above top of ground.

(4) casing PRC, 165,  
 (material) (depth)  
 \_\_\_\_\_ if telescope see back.  
 (size)

(5) screen 15, 180  
 (length) (depth to top)  
32, galv  
 (size) (material)

(6) pump 1, 8  
 (HP) (yield gpm)  
electricity  
 (type power)

(7) electric log no  
 (yes or no)  
ups  
 (organization running log)

(8) how well bottom plugged PRC clay

<u>sand &amp; rock</u>	<u>100</u>	<u>180</u>
------------------------	------------	------------

CODED

DEC 10 1968

MISS. Bd. OF WATER COMMISSIONERS


DRILLERS REMARKS: \_\_\_\_\_

If well telescopes please sketch and show depths.

GROUND LEVEL

Casing 165

Screen 180

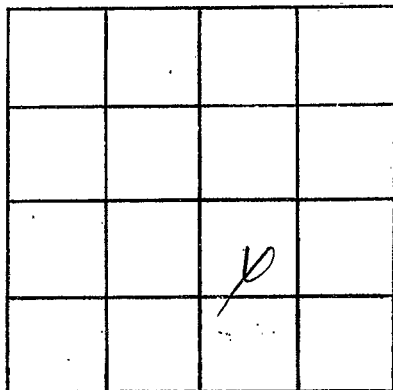

SECTION 25

Please indicate well location X.

ADDITIONAL INFORMATION

If more than one screen, show locations of each on sketch.