

Lippah  
7-12  
12-27-68

MISSISSIPPI  
 BOARD OF WATER COMMISSIONERS  
 416 North State Street  
 Jackson, Mississippi 39201

CODED

WATER WELL DRILLERS LOG

12-27- 1968 Jasper Well Co. Lippah  
 date well completed firm name county well located


LANDOWNER:	description of formations encountered	from	to
<u>D.C. Colyer</u> <u>Rt #4, Ripley, Miss.</u> (mailing address)	<u>Mixed Clay</u>	<u>0</u>	<u>50</u>
WELL LOCATION: sec <u>29</u> T <u>3</u> S R <u>4</u> E <u>4</u> miles <u>NE</u> of <u>Ripley</u> (distance) (direction) (nearest town)	<u>Blue Clay</u>	<u>50</u>	<u>150</u>
WELL PURPOSE: <u>home</u> (home, irrigation, municipal, industrial)	<u>Rock + Sand</u>	<u>150</u>	<u>200</u>
WELL COMPLETION DATA: (1) diameter (inches) <u>4"</u> (2) total depth (feet) <u>200 ft.</u> (3) static water level (feet) <u>80</u> below top of ground. (4) casing <u>PVC</u> <u>100</u> (material) (depth) <u>No</u> if telescope see back. (size) (5) screen <u>0</u> <u>0</u> (length) (depth to top) <u>0</u> <u>0</u> (size) (material) (6) pump <u>1 H.P.</u> <u>8</u> (HP) (yield gpm) <u>Elec.</u> (type power) (7) electric log <u>no</u> (yes or no) (organization running log) (8) how well bottom plugged <u>0</u>			
DRILLERS REMARKS:			

APR - 9 1968

MISS. BD. OF  
 WATER COMMISSIONERS

If well telescopes please  
sketch and show depths.

GROUND LEVEL

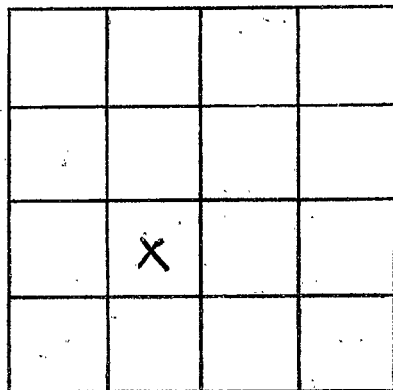

SECTION 29

Please indicate well location X.

ADDITIONAL INFORMATION

If more than one screen,  
show locations of each on sketch.