

CODED

MISSISSIPPI  
BOARD OF WATER COMMISSIONERS  
416 North State Street  
Jackson, Mississippi 39201

TIPPAH  
F 14  
1-19-70

WATER WELL DRILLERS LOG

1-19-70 1970 J.F. Madhain Tippah  
date well completed firm name county well located

LANDOWNER: Dobler Bates  
Pipley R # 2  
Pipley Miss  
(mailing address)

description of formations encountered	from	to
	<u>Red Clay</u>	<u>0</u>
<u>Red sandstone</u>	<u>30</u>	<u>80</u>
<u>Block</u>	<u>80</u>	<u>85</u>
<u>Yellow clay</u>	<u>83</u>	<u>90</u>
<u>White sandstone</u>	<u>90</u>	<u>138</u>

WELL LOCATION:  
sec. 2 T. 3 N. R. 4 E.  
3 miles W of Paralee  
(distance) (direction) (nearest town)

WELL PURPOSE:  
(home, irrigation, municipal, industrial)

WELL COMPLETION DATA:


- (1) diameter (inches) 4 1/2
- (2) total depth (feet) 138
- (3) static water level (feet) 9 below above top of ground.
- (4) casing P 138  
(material) (depth)  
(size) if telescope see back.
- (5) screen 40 98  
(length) (depth to top)  
4 P  
(size) (material)
- (6) pump 1 6  
(HP) (yield gpm)  
E  
(type power)
- (7) electric log (yes or no)  
(organization running log)
- (8) how well bottom plugged Blue clay Feb 2 = 1970

DRILLERS REMARKS:

MISSISSIPPI  
BOARD OF WATER COMMISSIONERS  
416 NORTH STATE STREET  
JACKSON, MISSISSIPPI 39201

If well telescopes please sketch and show depths.

GROUND LEVEL

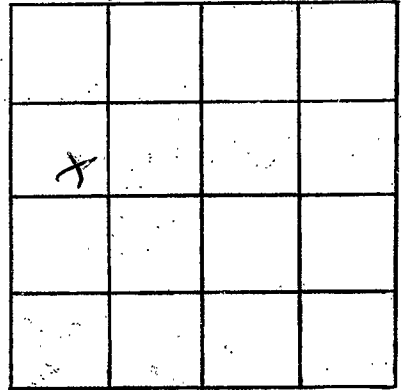

SECTION \_\_\_\_\_

Please indicate well location X.

ADDITIONAL INFORMATION

If more than one screen, show locations of each on sketch.