

MISSISSIPPI
BOARD OF WATER COMMISSIONERS
416 North State Street
Jackson, Mississippi 39201

CODED

WATER WELL DRILLERS LOG

Tippah
File
6-5-70

6-5-1970 date well completed
J.T. McEllin firm name
Tippah county/well located

LANDOWNER:
Earnest Sweatman
Ripley Miss
(mailing address)

| description of formations encountered | from | to |
|---------------------------------------|------|-----|
| Red CLAY | 0 | 19 |
| " SAND | 19 | 70 |
| Yellow CLAY | 70 | 84 |
| SAND | 84 | 109 |
| Rock | 109 | 102 |
| SAND | 112 | 123 |
| Rock | 125 | 124 |
| SAND | 124 | 142 |
| Blue CLAY | 142 | 150 |

WELL LOCATION:
sect 34 T3 N R 4 E
4 miles E of Ripley
(distance) (direction) (nearest town)

WELL PURPOSE:
(home, irrigation, municipal, industrial)

WELL COMPLETION DATA:

(1) diameter (inches) 4

(2) total depth (feet) 150

(3) static water level (feet) 70 below top of ground

(4) casing P 150 (material) (depth)
If telescope see back.

(5) screen 40 150 (length) (depth to top)
4 P (size) (material)

(6) pump 1 7 (HP) (yield gpm)
E (type power)

(7) electric log (yes or no)

(organization running log)

(8) how well bottom plugged Blue clay

CODED


JUL 1 1970

MISC. BD. OF
WATER COMM.

DRILLERS REMARKS:

If well telescopes please sketch and show depths.

GROUND LEVEL

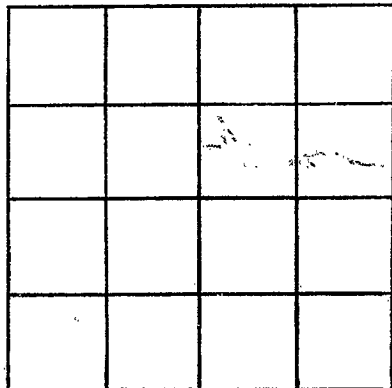

SECTION _____

Please indicate well location X.

ADDITIONAL INFORMATION

If more than one screen,
show locations of each on sketch.