

TIPPAH
F17
10-3-70

MISSISSIPPI
BOARD OF WATER COMMISSIONERS
416 North State Street
Jackson, Mississippi 39201

CODED

WATER WELL DRILLERS LOG

10 3 1970
date well completed

J T Medlin
firm name

Tippah
county well located

LANDOWNER: J H. Highley

~~Right of farmer~~

(mailing address)

WELL LOCATION:

sec. 3 T. 3 N. R. 4 E
5 miles E of Falkner
(distance) (direction) (nearest town)

WELL PURPOSE:

(home, irrigation, municipal, industrial)

WELL COMPLETION DATA:

- (1) diameter (inches) 4
- (2) total depth (feet) 170
- (3) static water level (feet) 118 below top of ground.
- (4) casing P 170 (material) (depth)
(size) if telescope see back.
- (5) screen 80 130 (length) (depth to top)
(size) (material)
- (6) pump 1 1/2 7 (HP) (yield gpm)
(type power)
- (7) electric log (yes or no)
(organization running log)
- (8) how well bottom plugged

description of formations encountered

from

to

Red clay	0	18
Blue Rock	18	42
Blue SAND	42	51
Blue SAND	51	62
Blue SAND	62	80
Blue SAND	80	93
Blue SAND	93	120
Blue SAND	120	128
Blue SAND	128	148
Blue SAND	148	154
Blue SAND	154	170

CODED


NOV 4 - 1970

DRILLERS REMARKS:

MISS. Bd. of
WATER COMMISSIONERS

If well telescopes please sketch and show depths.

GROUND LEVEL

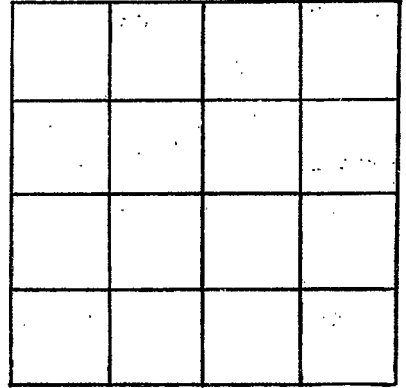

SECTION _____

Please indicate well location X.

ADDITIONAL INFORMATION

If more than one screen,
show locations of each on sketch.