

TIPPAM
 F18
 6-10-70

MISSISSIPPI
 BOARD OF WATER COMMISSIONERS
 416 North State Street
 Jackson, Mississippi 39201

CODED

WATER WELL DRILLERS LOG

6-10-70 19 Junper Well Drllg Tippah
 date well completed firm name county well located

LANDOWNER:
Bonnie Cappleman
Ripley, Miss
 (mailing address)

description of formations encountered	from	to
<u>Mixed clay</u>	<u>0</u>	<u>150</u>
<u>Rock & sand</u>	<u>150</u>	<u>220</u>

WELL LOCATION:
 sec. 29 T. 3 N. R. 4 E
4 miles NE of Ripley
 (distance) (direction) (nearest town)

WELL PURPOSE: Home
 (home, irrigation, municipal, industrial)

- WELL COMPLETION DATA:
- (1) diameter (inches) 4"
 - (2) total depth (feet) 220
 - (3) static water level (feet) 150 below above top of ground.
 - (4) casing PVC, 200
 (material) (depth)
4"
 (size) if telescope see back.
 - (5) screen 20, 200
 (length) (depth to top)
1/32, PVC
 (size) (material)
 - (6) pump 1/2, 8
 (HP) (yield gpm)
 - ELEC
 (type power)
 - (7) electric log 0
 (yes or no)

CODED

(8) how well bottom plugged PVC cap
 (organization running log)

JUN 25 1971

MISS. BD. OF
 WATER COMM.

DRILLERS REMARKS:

If well telescopes please sketch and show depths.

GROUND LEVEL


CLAY

150

Rock

↓
SAND

220

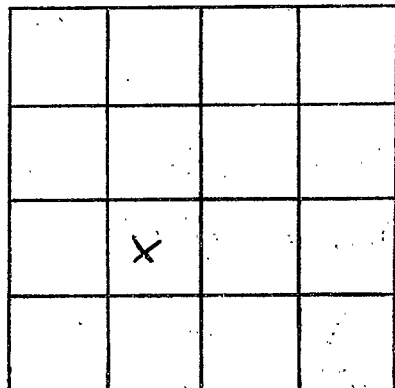

SECTION 29

Please indicate well location X.

ADDITIONAL INFORMATION

If more than one screen,
show locations of each on sketch.