

MISSISSIPPI
BOARD OF WATER COMMISSIONERS
416 North State Street
Jackson, Mississippi 39201

CODED

WATER WELL DRILLERS LOG

TIPPAH
F19
8-17-70

8-17-70¹⁹ date well completed
Junger Well Drdg firm name
Tippah county, well located

LANDOWNER:
Grady Adams
Ripley Miss
(mailing address)

description of formations encountered	from	to
Mixed Clay	0	50
Blue Clay	50	150
Rock + Sand	150	200

WELL LOCATION:
sec. 29 T. 3 N. R. 4 E
S
5 miles N 2 of Ripley
(distance) (direction) (nearest town)

WELL PURPOSE: Home
(home, irrigation, municipal, industrial)

- WELL COMPLETION DATA:
- (1) diameter (inches) 4
 - (2) total depth (feet) 200
 - (3) static water level (feet) 50 below top of ground.
 - (4) casing PVC, 100, (material), (depth)
No (size) if telescope see back.
 - (5) screen 0, 0 (length), (depth to top)
0, 0 (size), (material)
 - (6) pump 1, 8 (HP), (yield gpm)
Elec (type power)
 - (7) electric log No (yes or no)
0 (organization running log)
 - (8) how well bottom plugged 0

CODED


JUN 25 1971

DRILLERS REMARKS:

MISS. BD. OF
WATER COMM.

If well telescopes please sketch and show depths.

GROUND LEVEL

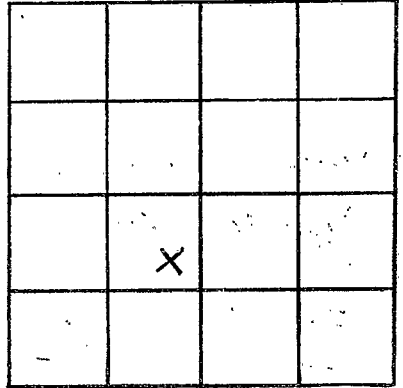

SECTION 29

Please indicate well location X.

ADDITIONAL INFORMATION

If more than one screen, show locations of each on sketch.