

TIPPAH  
F20  
10-28-71

MISSISSIPPI  
BOARD OF WATER COMMISSIONERS  
416 North State Street  
Jackson, Mississippi 39201

CODED

660.00  
3300  
\$695.00

WATER WELL DRILLERS LOG

10 28 1971 date well completed  
J T Medlin firm name  
Tippah county/well located

LANDOWNER: William W. Ripley  
Ripley, Miss  
(mailing address)

description of formations encountered	from	to
Clay	0	18
Blue "O" Rock	18	62
Sand	62	68
Blue clay	68	118
Rock & Sand	118	180

WELL LOCATION:  
sec. 32 T. 3 N. R. 4 E.  
3 miles NE of Ripley  
(distance) (direction) (nearest town)

WELL PURPOSE:  
(home, irrigation, municipal, industrial)

- WELL COMPLETION DATA:
- (1) diameter (inches) 4
  - (2) total depth (feet) 180
  - (3) static water level (feet) 100 below top of ground.
  - (4) casing P (material), 90 (depth).  
(size) if telescope see back.
  - (5) screen 0 (length), (depth to top)  
(size) (material)
  - (6) pump 1/2 (HP), 3 (yield gpm)  
(type power)
  - (7) electric log (yes or no)
  - (organization running log)
  - (8) how well bottom plugged

CODED


NOV 16 1971

MISS. BD. OF  
WATER COMMISSIONERS

DRILLERS REMARKS:

If well telescopes please sketch and show depths.

GROUND LEVEL

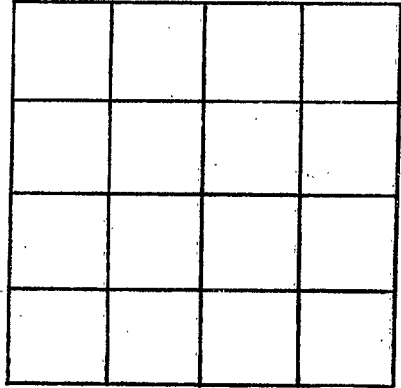

SECTION \_\_\_\_\_

Please indicate well location X.

ADDITIONAL INFORMATION

A series of horizontal lines for recording additional information, starting below the 'ADDITIONAL INFORMATION' header and extending to the bottom of the page.

If more than one screen, show locations of each on sketch.