

**MISSISSIPPI
BOARD OF WATER COMMISSIONERS**
416 North State Street
Jackson, Mississippi 39201

WATER WELL DRILLERS LOG

Tippah
F21
6-66

6-16 1966 *Robert W. Wilson* *Tippah*
date well completed firm name county well located

LANDOWNER: *Ferehel Childs*
Tiptersville
Miss.
(mailing address)


WELL LOCATION:
sec. *9* T. *3* N R. *4* E
4 miles *E* of *Falkner*
(distance) (direction) (nearest town)

WELL PURPOSE: *home*
(home, irrigation, municipal, industrial)

WELL COMPLETION DATA:

- (1) diameter (inches) 4"
- (2) total depth (feet) 195'
- (3) static water level (feet) 170' ^{below} _{above} top of ground.
- (4) casing Plastic 191'
(material) (depth)
4" if telescope see back.
(size)
- (5) screen 4' 191'
209au (length) (depth to top)
4" Outpac Slotted Pipe
(size) (material)
- (6) pump 1
(HP) (yield gpm)
Elect.
(type power)
- (7) electric log NO
(yes or no)
(organization running log)
- (8) how well bottom plugged 4"
plastic cap

description of formations encountered	from	to
<i>Red dirt</i>	<i>0</i>	<i>10</i>
<i>Blue dirt</i>	<i>10</i>	<i>20</i>
<i>Rock & clay</i>	<i>20</i>	<i>30</i>
<i>Red sand</i>	<i>30</i>	<i>80</i>
<i>White Sand Rock & clay</i>	<i>80</i>	<i>100</i>
<i>Red sand</i>	<i>100</i>	<i>110</i>
<i>Red sand & Rock</i>	<i>110</i>	<i>120</i>
<i>Blue clay & Red Sand</i>	<i>120</i>	<i>160</i>
<i>Blue clay & Green sand</i>	<i>160</i>	<i>170</i>
<i>White Sand</i>	<i>170</i>	<i>195</i>

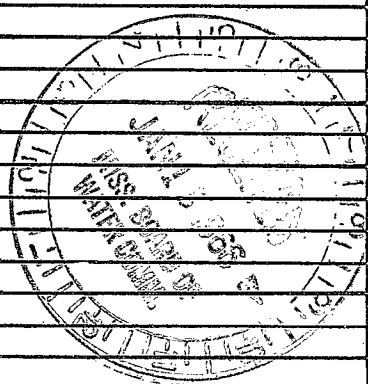

DRILLERS REMARKS:

If well telescopes please sketch and show depths.

GROUND LEVEL

SECTION _____

Please indicate well location X.

ADDITIONAL INFORMATION

If more than one screen, show locations of each on sketch.