

Tippana
 OF22
 9-25-68

Well started 9/16/68

MISSISSIPPI
 BOARD OF WATER COMMISSIONERS
 416 North State Street
 Jackson, Mississippi 39201

WATER WELL DRILLERS LOG

9-25-1968 T Medlin TIPPAHA
 date well completed firm name county well located


LANDOWNER: F. I. J. J. J. J.
 Hwy. 15 N Ripley
 MISS
 (mailing address)

WELL LOCATION:
 sec. 30 T. 3 N R. 4 E
 3 miles S. of Falkner
 (distance) (direction) (nearest town)

WELL PURPOSE: DAIRY
 (home, irrigation, municipal, industrial)

- WELL COMPLETION DATA:
- (1) diameter (inches) 5"
 - (2) total depth (feet) 300
 - (3) static water level (feet) 163 (below) above top of ground.
 - (4) casing PLASTIC 300 (material) (depth)
 (size) If telescope see back.
 - (5) screen 60 240 (length) (depth to top)
 5" PLASTIC (size) (material)
 - (6) pump 1.5 800 (HP) (yield gpm)
 E (type power)
 - (7) electric log (yes or no)
 (organization running log)
 - (8) how well bottom plugged


description of formations encountered	from	to
White Sandstone	0	16
Blue Clay	16	27
Blue Clay	27	42
Rock	42	46
Blue Sand	46	60
Blue Clay	60	120
Rock	120	142
Blue Clay	142	170
White Sand	170	230
Rock	230	236
White Sand	236	290
Blue Clay	290	300

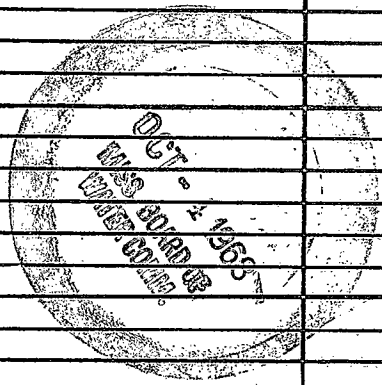

DRILLERS REMARKS:

If well telescopes please sketch and show depths.

GROUND LEVEL

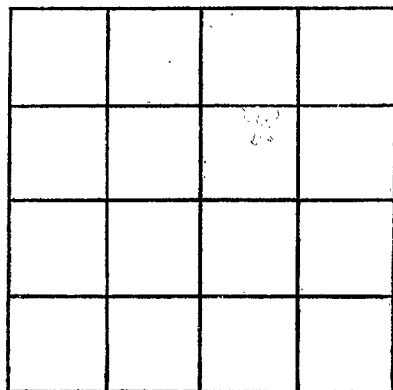

SECTION _____

Please indicate well location X.

ADDITIONAL INFORMATION

If more than one screen,
show locations of each on sketch.