

TIPPAH
F23 CODED
7-26-72

MISSISSIPPI
 BOARD OF WATER COMMISSIONERS
 416 North State Street
 Jackson, Mississippi 39201

\$ 600.00 For well
 30.00 tax
 570.00

WATER WELL DRILLERS LOG

7-26-72 date well completed
 J.T. Medlin firm name
 Tippah N county well located

LANDOWNER: Jamae Smith Ford
RTH Y
Ripley Miss
 (mailing address)

description of formations encountered	from	to
clay	0	20
Rock sand	20	50
Blue clay	50	120
sand, Rock	120	180

WELL LOCATION:
 sec 32 T 3 N R 40
3 miles N.E. of Ripley
 (distance) (direction) (nearest town)

WELL PURPOSE:
 (home, irrigation, municipal, industrial)

- WELL COMPLETION DATA:
- (1) diameter (inches) 4 1/2
 - (2) total depth (feet) 180
 - (3) static water level (feet) 120 below top of ground.
 - (4) casing Plastic 80'
 (material) (depth)
 - _____ if telescope see back.
 (size)
 - (5) screen 0
 (length) (depth to top)
 - _____ (size) _____ (material)
 - (6) pump 1/2 8
 (HP) (yield gpm)
 - Electric
 (type power)
 - (7) electric log _____
 (yes or no)
 - _____ (organization running log)
 - (8) how well bottom plugged _____


AUG 22 1972

MISS. BL. OF
 WATER

DRILLERS REMARKS:

If well telescopes please sketch and show depths.

GROUND LEVEL

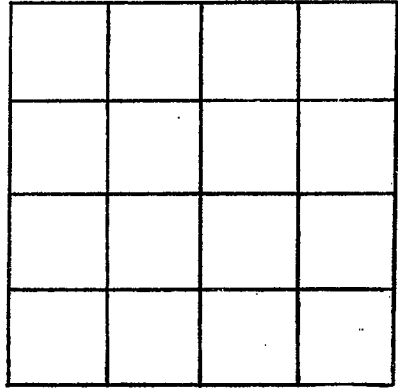

SECTION _____

Please indicate well location X.

ADDITIONAL INFORMATION

If more than one screen,
show locations of each on sketch.