

TIPPAH
F24
9-16-72

MISSISSIPPI
BOARD OF WATER COMMISSIONERS
416 North State Street
Jackson, Mississippi 39201

\$ 800 00
45 00
845 00

WATER WELL DRILLERS LOG

CODED

9-16-1972 date well completed
J. T. Medlin firm name
Tippah county well located

LANDOWNER:
Robby Bertley
Ruploff
(mailing address)

description of formations encountered	from	to
Clay	0	19
" & sand	19	62
Sand & rock	62	145

WELL LOCATION:
sec. 22 T 3 N R 4 E
3 miles N of Peoples
(distance) (direction) (nearest town)

WELL PURPOSE:
(home, irrigation, municipal, industrial)

- WELL COMPLETION DATA:
- (1) diameter (inches) 4
 - (2) total depth (feet) 145
 - (3) static water level (feet) 22 below top of ground.
 - (4) casing P 145
(material) (depth)
If telescope see back.
 - (5) screen 10 135
(length) (depth to top)
4 P
(size) (material)
 - (6) pump 1 5
(HP) (yield gpm)
E
(type power)
 - (7) electric log (yes or no)
 - (organization running log)
 - (8) how well bottom plugged

CODED


NOV 10 1972

DRILLERS REMARKS:

MISS. BD. OF
WATER COMMISSIONERS

If well telescopes please sketch and show depths.

GROUND LEVEL

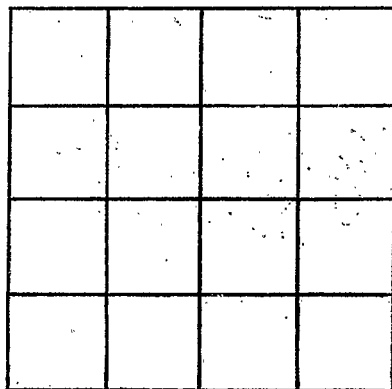

SECTION _____

Please indicate well location X.

ADDITIONAL INFORMATION

If more than one screen,
show locations of each on sketch.