

TIPPAH
 F 26
 10-20-71
 10-20-71
 date well completed

MISSISSIPPI
 BOARD OF WATER COMMISSIONERS
 416 North State Street
 Jackson, Mississippi 39201

WATER WELL DRILLERS LOG

Jumpin Well Drilling firm name
Tipah county well located

LANDOWNER:	description of formations encountered	from	to
<i>Mrs. Dillie Clark</i> <i>Rt # 2, Ripley</i> (mailing address)	<i>mixed clay</i>	<i>0</i>	<i>150</i>
WELL LOCATION: sec <i>29</i> T <i>3</i> N R <i>4</i> E <i>4</i> miles <i>NE</i> of <i>Ripley</i> (distance) (direction) (nearest town)	<i>Rock & sand</i>	<i>150</i>	<i>220</i>
WELL PURPOSE: <i>Home</i> (home, irrigation, municipal, industrial)			
WELL COMPLETION DATA:			
(1) diameter (inches) <i>4 1/2</i>			
(2) total depth (feet) <i>220</i>			
(3) static water level (feet) <i>150</i> below top of ground above			
(4) casing <i>PVC</i> <i>200</i> (material) (depth) <i>4</i> (size) If telescope see back.			
(5) screen <i>20</i> <i>200</i> (length) (depth to top) <i>1/32</i> <i>PVC</i> (size) (material)			
(6) pump <i>1 1/2</i> <i>8</i> (HP) (yield gpm) <i>Elec</i> (type power)			
(7) electric log (yes or no) <i>0</i>			
(organization running log)			
(8) how well bottom plugged			
DRILLERS REMARKS:			

NOV 20 1972

MISS. B.U. 02
 EAT-DRILLING RECORDS

If well telescopes please sketch and show depths.

GROUND LEVEL


Clay

150

Rock

+
Sand

220

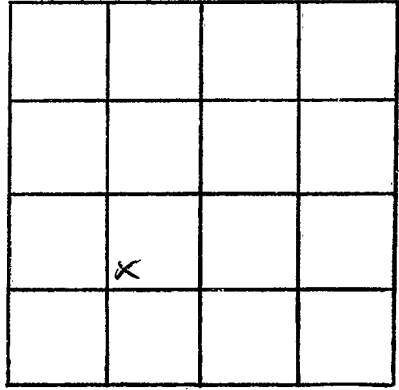

SECTION 29

Please indicate well location X.

ADDITIONAL INFORMATION

If more than one screen, show locations of each on sketch.