

TIPPAH  
 F 27  
 11-2-70

MISSISSIPPI  
 BOARD OF WATER COMMISSIONERS  
 416 North State Street  
 Jackson, Mississippi 39201


WATER WELL DRILLERS LOG

11-270 19 \_\_\_\_\_ firm name *Joseph A. Hill* \_\_\_\_\_ county well located *Tippah*

LANDOWNER:	description of formations encountered	from	to
<i>Cornelius Adams</i> <i>Kyley Miss</i> (mailing address)	<i>Green clay</i>	0	50
WELL LOCATION: sec. <i>27</i> T. <i>3</i> N. R. <i>4</i> E <i>5</i> miles <i>SE</i> of <i>Kyley</i> (distance) (direction) (nearest town)	<i>Blue clay</i>	50	150
WELL PURPOSE: (home, irrigation, municipal, industrial)	<i>Rock + Sand</i>	150	300
WELL COMPLETION DATA:			
(1) diameter (inches) <i>4"</i>			
(2) total depth (feet) <i>300</i>			
(3) static water level (feet) <i>80</i> below above top of ground.			
(4) casing <i>PVC</i> <i>100</i> (material) (depth) <i>2"</i> (size) if telescope see back.			
(5) screen (length) (depth to top) <i>0</i> <i>0</i> (size) (material)			
(6) pump <i>1/2 HP</i> <i>8</i> (HP) (yield gpm) <i>Egen</i> (type power)			
(7) electric log (yes or no) <i>0</i> (organization running log) <i>0</i>			
(8) how well bottom plugged <i>0</i>			
DRILLERS REMARKS:	<i>NOV 21 1972</i>		

If well telescopes please sketch and show depths.

GROUND LEVEL

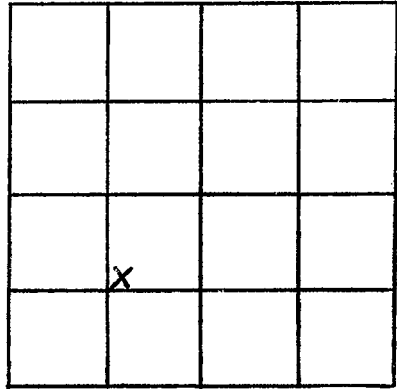

SECTION 29

Please indicate well location X.

ADDITIONAL INFORMATION

If more than one screen,  
show locations of each on sketch.