

TIPPAH
 F 28
 9-10-72

MISSISSIPPI
 BOARD OF WATER COMMISSIONERS
 416 North State Street
 Jackson, Mississippi 39201

CODED

WATER WELL DRILLERS LOG

9-10-72 1972 date well completed
 Jumper Well Drilling firm name
 Tippah county well located

LANDOWNER:
 Sumner B. Cox
 R.F. # 4 Ripley (mailing address)

description of formations encountered
 from to
 Miss clay 0 50

WELL LOCATION:
 sec 27 T 3 N R 4 E
 4 S W
 (distance) miles (direction) of (nearest town)

Sand & Rock 180 250

WELL PURPOSE:
 (home, irrigation, municipal, industrial)

WELL COMPLETION DATA:
 (1) diameter (inches) 4"
 (2) total depth (feet) 250
 (3) static water level (feet) 70 below top of ground.
 (4) casing PVC 120 (material) (depth)
 (size) if telescope see back.
 (5) screen 0 0 (length) (depth to top)
 (size) (material)
 (6) pump 1/2 (HP) 8 (yield gpm)
 Elec (type power)
 (7) electric log 0 (yes or no)
 (organization running log)
 (8) how well bottom plugged 0

CODED


DEC 11 1972

MISS. DIV. OF WATER CONTROL

DRILLERS REMARKS:

If well telescopes please sketch and show depths.

GROUND LEVEL

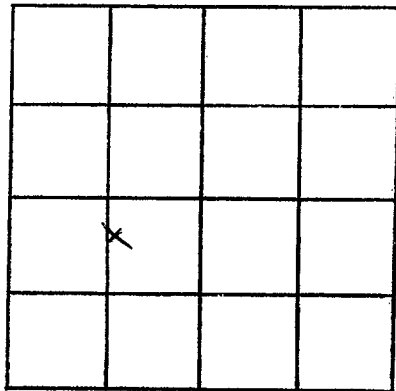

SECTION 29

Please indicate well location X.

ADDITIONAL INFORMATION

Lined area for additional information.

If more than one screen, show locations of each on sketch.