

TIPPAH
 F 29
 9-25-72

MISSISSIPPI
 BOARD OF WATER COMMISSIONERS
 416 North State Street
 Jackson, Mississippi 39201

CODED

WATER WELL DRILLERS LOG

9 25 1972 date well completed
 Jumper Well Drilling firm name
 Tippah county well located

LANDOWNER: Jerry Rattiff
 description of formations encountered: Shief Clay
 from 0 to 50
 to

WELL LOCATION:
 sec. 29 T 3 R 4 E
 4 miles NE of Ripley
 (distance) (direction) (nearest town)

Blue Clay 50 150
 Rock and sand 150 200

WELL PURPOSE:
 (home, irrigation, municipal, industrial)

WELL COMPLETION DATA:
 (1) diameter (inches) 4"
 (2) total depth (feet) 200
 (3) static water level (feet) 50 below top of ground.
 (4) casing PVC 100 (material) (depth)
 (size) if telescope see back.
 (5) screen (length) (depth to top)
 (size) (material)
 (6) pump 1 (HP) 8 (yield gpm)
 Elec (type power)
 (7) electric log no (yes or no)
 (organization running log)
 (8) how well bottom plugged 0


CODED

SEP 11 1972

DRILLERS REMARKS:

If well telescopes please sketch and show depths.

GROUND LEVEL

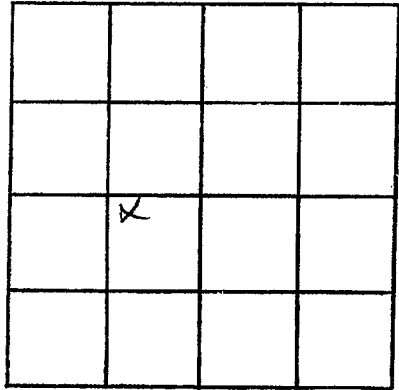

SECTION 29

Please indicate well location X.

ADDITIONAL INFORMATION

A series of horizontal lines for writing additional information.

If more than one screen, show locations of each on sketch.