

TIPPAH
F 30
5-10-72

MISSISSIPPI
BOARD OF WATER COMMISSIONERS
416 North State Street
Jackson, Mississippi 39201

CODED

WATER WELL DRILLERS LOG

5-10 1972 *Juniper Well Drilling* firm name *Jayak* county well located


LANDOWNER:	description of formations encountered	from	to
<p><i>Pearl A. Haddip</i> <i>Rt #4 Ripley Miss</i> (mailing address)</p>	<p><i>met clay</i></p>	<p><i>0</i></p>	<p><i>50</i></p>
<p>WELL LOCATION: sec. <i>29</i> T. <i>3</i> N. R. <i>4</i> E <i>4</i> miles <i>NE</i> of <i>Ripley</i> (distance) (direction) (nearest town)</p>	<p><i>Blue Clay</i></p>	<p><i>50</i></p>	<p><i>150</i></p>
<p>WELL PURPOSE: <i>Home</i> (home, irrigation, municipal, industrial)</p>	<p><i>Rock zone</i></p>	<p><i>150</i></p>	<p><i>200</i></p>
WELL COMPLETION DATA:			
(1) diameter (inches) <i>4"</i>	CODED		
(2) total depth (feet) <i>200 ft</i>			
(3) static water level (feet) <i>80</i> below top of ground.			
(4) casing <i>PVC 100 ft.</i> (material) (depth)			
<i>No</i> if telescope see back. (size)			
(5) screen <i>0 0</i> (length) (depth to top)			
(size) <i>1</i> (material) <i>8</i>			
(6) pump (HP) (yield gpm) <i>Elec</i>			
(7) electric log <i>No</i> (yes or no)			
(organization running log) <i>0</i>			
(8) how well bottom plugged <i>0</i>			
DRILLERS REMARKS:			

DEC 11 1972

MISSISSIPPI BOARD OF WATER COMMISSIONERS
JACKSON, MISSISSIPPI

If well telescopes please sketch and show depths.

GROUND LEVEL

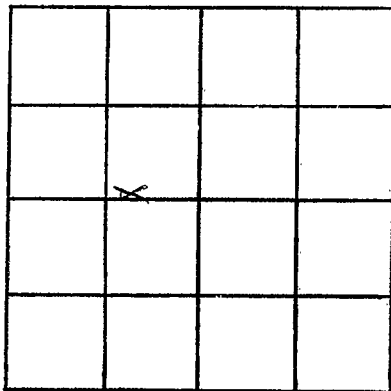

SECTION 29

Please indicate well location X.

ADDITIONAL INFORMATION

If more than one screen,
show locations of each on sketch.