

TIPPAH
 F 31
 5-17-72
 5-17-72
 date well completed

MISSISSIPPI
 BOARD OF WATER COMMISSIONERS
 416 North State Street
 Jackson, Mississippi 39201

WATER WELL DRILLERS LOG

CODED

Juniper Well Drilling firm name
Tippah county well located

LANDOWNER:
Lemmie C. Reardon
RT #1 Joplinville
 (mailing address)

description of formations encountered	from	to
<i>mid clay</i>	<i>0</i>	<i>150</i>
<i>Rock + Sand</i>	<i>150</i>	<i>220</i>

WELL LOCATION:
 sec 13 T 3 R 4
8 miles E of Jackson
 (distance) (direction) (nearest town)

WELL PURPOSE:
Home
 (home, irrigation, municipal, industrial)

- WELL COMPLETION DATA:
- diameter (inches) 4"
 - total depth (feet) 200 ft
 - static water level (feet) 150 below top of ground.
 - casing PVC 200
 (material) (depth)
4"
 (size) if telescope see back.
 - screen 20 200
 (length) (depth to top)
1/32 PVC
 (size) (material)
 - pump 1/2 8
 (HP) (yield gpm)
Electric
 (type power)
 - electric log 0
 (yes or no)
0
 (organization running log)
 - how well bottom plugged PVCCP

CODED

DEC 11 1972

MISSISSIPPI
 BOARD OF WATER COMMISSIONERS

DRILLERS REMARKS:

If well telescopes please sketch and show depths.


GROUND LEVEL

Clay

15° J/A

Rock
&
Sand

220 ft

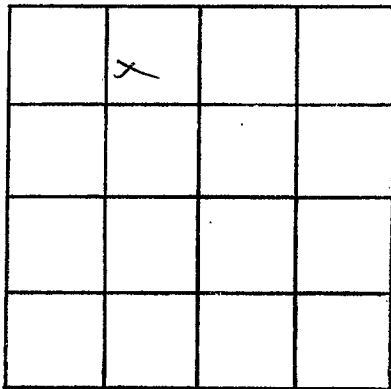

SECTION 13

Please indicate well location X.

ADDITIONAL INFORMATION

If more than one screen,
show locations of each on sketch.