

TIPPAH
 F 32
 6-10-72
 6-10-72
 date well completed

MISSISSIPPI
 BOARD OF WATER COMMISSIONERS
 416 North State Street
 Jackson, Mississippi 39201

CODED

WATER WELL DRILLERS LOG

Jumper Well Drilling Tippan
 firm name county well located


LANDOWNER:	description of formations encountered	from	to
James F. Johnson Rt # 40 Tipton Miss (mailing address)			
WELL LOCATION: sec 29 T 3 N R 4 E 4 miles NE of Tipton (distance) (direction) (nearest town)	Blue Clay	50	150
WELL PURPOSE: (home, irrigation, municipal, industrial)	Rock & sand	150	200
WELL COMPLETION DATA:	CODED		
(1) diameter (inches) 4"			
(2) total depth (feet) 200			
(3) static water level (feet) 80 below top of ground.			
(4) casing PVC 100 (material) (depth)			
(size) If telescope see back.			
(5) screen 0 0 (length) (depth to top)			
(size) (material)			
(6) pump 1 8 (HP) (yield gpm)			
(type power) Elec			
(7) electric log 10 (yes or no)			
(organization running log)			
(8) how well bottom plugged 0			
DRILLERS REMARKS:			

DEPT 11 872

MISSISSIPPI BOARD OF WATER COMMISSIONERS

If well telescopes please sketch and show depths.

GROUND LEVEL

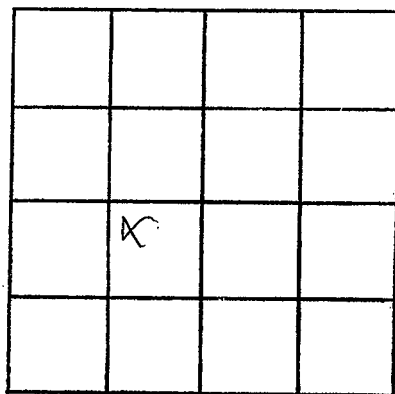

SECTION 29

Please indicate well location X.

ADDITIONAL INFORMATION

If more than one screen,
show locations of each on sketch.