

TIPPAH
F 33
2-21-72

MISSISSIPPI
BOARD OF WATER COMMISSIONERS
416 North State Street
Jackson, Mississippi 39201

WATER WELL DRILLERS LOG

CODED

2-21-72 19 *Jumper Well Drilling* *Tipton*
date well completed firm name county well located

LANDOWNER:	description of formations encountered	from	to
<i>James W. Calyer</i> <i>Rt #4, Ripley Miss</i> (mailing address)			
WELL LOCATION: sec <i>29</i> T <i>3</i> R <i>4</i> E <i>4</i> miles <i>NE</i> of <i>Ripley</i> (distance) (direction) (nearest town)	<i>blue clay</i>	<i>50</i>	<i>150</i>
WELL PURPOSE: (home, irrigation, municipal, industrial)	<i>rock & sand</i>	<i>150</i>	<i>200</i>
WELL COMPLETION DATA:			
(1) diameter (inches) <i>4"</i>			
(2) total depth (feet) <i>200 ft</i>			
(3) static water level (feet) <i>80 ft</i> below top of ground			
(4) casing <i>PVC</i> <i>100</i> (material) (depth)			
<i>NO</i> if telescope see back. (size)			
(5) screen <i>0</i> <i>0</i> (length) (depth to top)			
<i>0</i> <i>0</i> (size) (material)			
(6) pump <i>1</i> <i>8</i> (HP) (yield gpm)			
<i>Electric</i> (type power)			
(7) electric log <i>No</i> (yes or no)			
(organization running log)			
(8) how well bottom plugged <i>0</i>			
DRILLERS REMARKS:			


CODED

MISSISSIPPI

If well telescopes please sketch and show depths.

Handwritten notes: 250' 0.00' 1.5' 0.00'

GROUND LEVEL

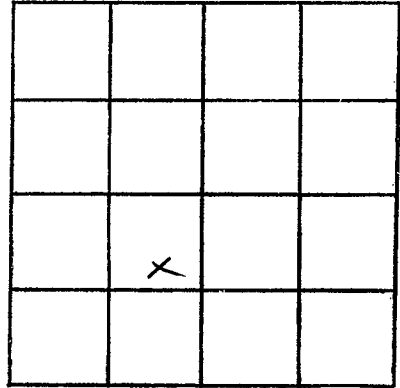

SECTION 29

Please indicate well location X.

ADDITIONAL INFORMATION

If more than one screen, show locations of each on sketch.