

TIPPAH  
F 35  
2-26-72

MISSISSIPPI  
BOARD OF WATER COMMISSIONERS  
416 North State Street  
Jackson, Mississippi

39201  
**CODED**

WATER WELL DRILLERS LOG

2-26-72 19 date well completed  
Super Well Drilling firm name  
Tippan county well located

LANDOWNER:  
John D. Stark  
Pt. #2 (Ripley)  
Blue Mountain (Ripley)

description of formations encountered	from	to
quicks clay	1	180
Shale & Rock	180	280

WELL LOCATION:  
sec 29 T 3 N R 4 E  
5 miles NE of Ripley  
(distance) (direction) (nearest town)

WELL PURPOSE:  
(home, irrigation, municipal, industrial)

- WELL COMPLETION DATA:
- (1) diameter (inches) 4 1/2
  - (2) total depth (feet) 250
  - (3) static water level (feet) 70 below top of ground.
  - (4) casing PVC 120 (material) (depth)
  - (size) If telescope see back.
  - (5) screen 0' 0' (length) (depth to top)
  - (size) 1/2 (material) 8 (HP) (yield gpm)
  - (6) pump Eden (type power)
  - (7) electric log NO (yes or no)
  - (organization running log)
  - (8) how well bottom plugged

**CODED**


DEC 11 1972

MISS. CO. 03

DRILLERS REMARKS:

If well telescopes please sketch and show depths.

GROUND LEVEL

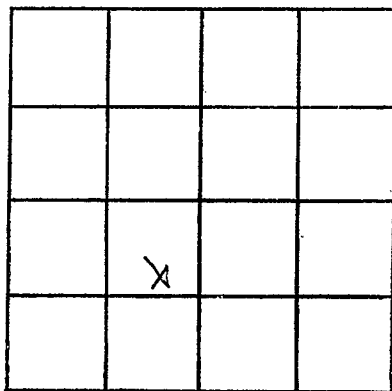

SECTION 29

Please indicate well location X.

ADDITIONAL INFORMATION

If more than one screen, show locations of each on sketch.