

TIPPAH
F 36
1-3-73

MISSISSIPPI
BOARD OF WATER COMMISSIONERS
416 North State Street
Jackson, Mississippi 39201

700 00
35 00
735 00

WATER WELL DRILLERS LOG

CODED

1-3-19 25 J. F. Medlin Tippan
date well completed firm name county well located

LANDOWNER:
J. A. Coombs
Ripley Miss
(mailing address)

description of formations encountered	from	to
<u>Clay</u>	<u>0</u>	<u>18</u>
<u>loam + clay</u>	<u>18</u>	<u>30</u>
<u>blue</u>	<u>50</u>	<u>120</u>
<u>rock & sand</u>	<u>130</u>	<u>180</u>

WELL LOCATION:
sec. 32 T. 40 N. R. 40
4 35 NE of Ripley
(distance) miles (direction) (nearest town)

WELL PURPOSE:
(home, irrigation, municipal, industrial)

- WELL COMPLETION DATA:
- (1) diameter (inches) 4
 - (2) total depth (feet) 180
 - (3) static water level (feet) 90 below top of ground.
 - (4) casing P 80
(material) (depth)
(size) if telescope see back.
 - (5) screen _____
(length) (depth to top)
(size) (material)
 - (6) pump 1/2 6
(HP) (yield gpm)
E
(type power)
 - (7) electric log _____
(yes or no)
(organization running log)
 - (8) how well bottom plugged open

CODED


FEB 5 1973

DRILLERS REMARKS:

MISS. BD. OF
WATER COMMISSIONERS

If well telescopes please
sketch and show depths.

GROUND LEVEL

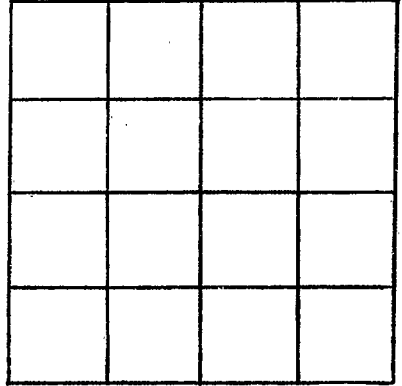

SECTION _____

Please indicate well location X.

ADDITIONAL INFORMATION

If more than one screen,
show locations of each on sketch.